


T.5 S. R. 3 E.W.M.

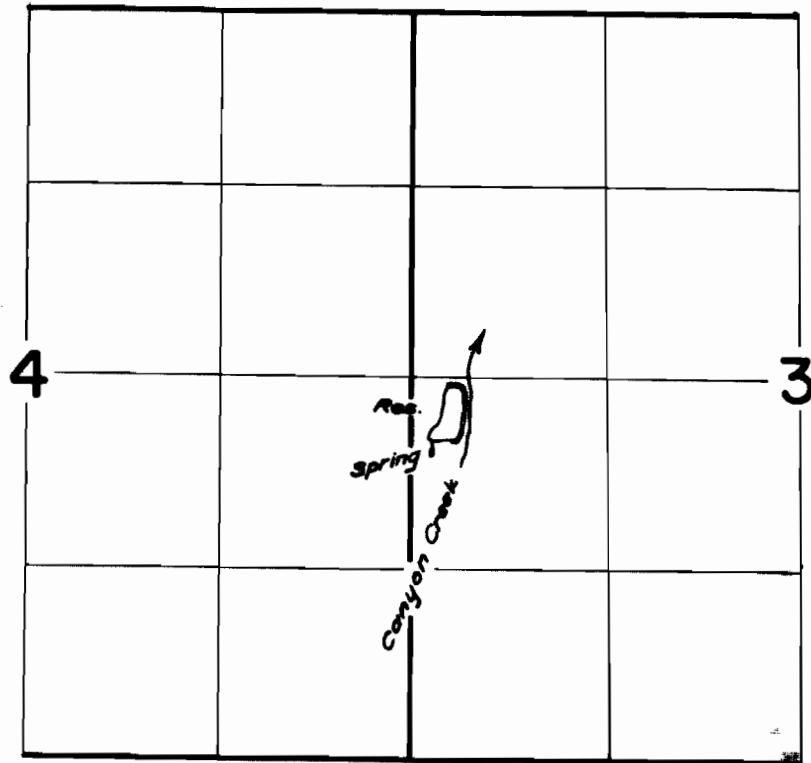

FINAL PROOF SURVEY
UNDER

Application No. **R-31194** ~~31195~~ Permit No. **R-2033** ~~24953~~
IN NAME OF

JAMES OCHAMPAUGH

Surveyed May 15, 1961, by *Al Jackson*