


T.5 S. R. 3 E.W.M.

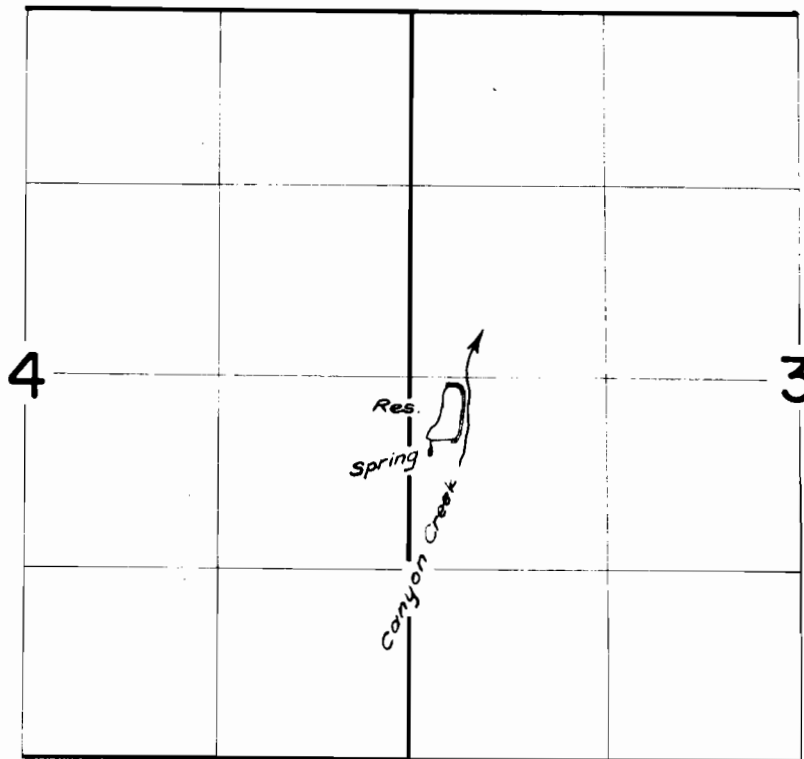

FINAL PROOF SURVEY
UNDER

Application No. **R-31194** 31195 Permit No. **R-2033** 24953
IN NAME OF

JAMES OCHAMPAUGH

Surveyed May 15 1961 by *D. Jackson*