


T.33S.R.IIW.W.M.

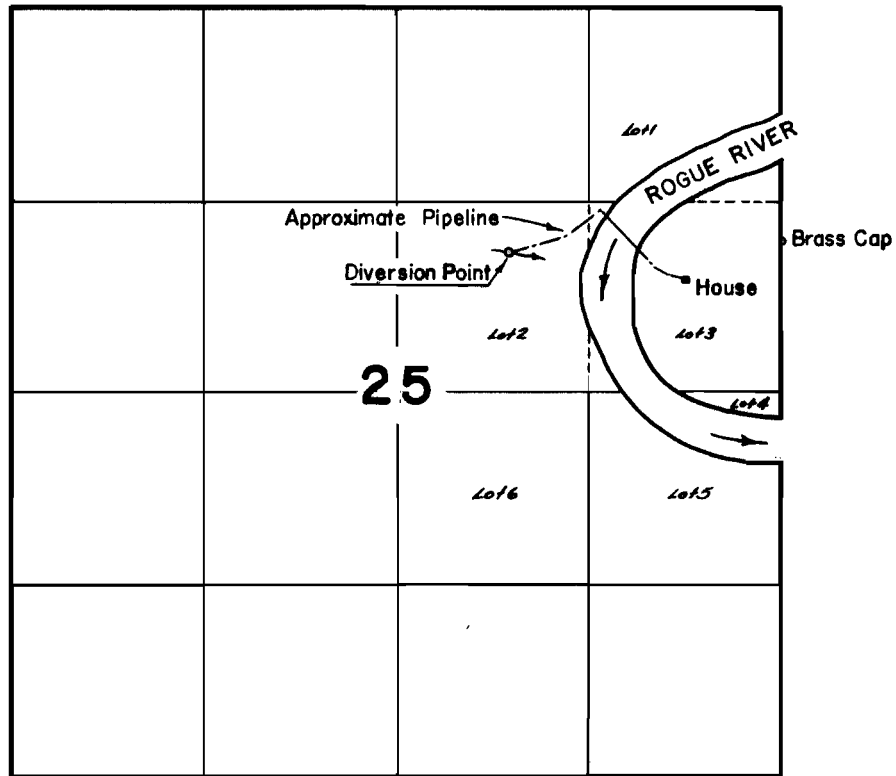

FINAL PROOF SURVEY
UNDER

Application No. 33483 Permit No. 26495
IN NAME OF

.....R. L. MORROW.....

Surveyed Aug. 23 1961, by C. O. Barlett.....