


T.30S.R.5W.W.M.

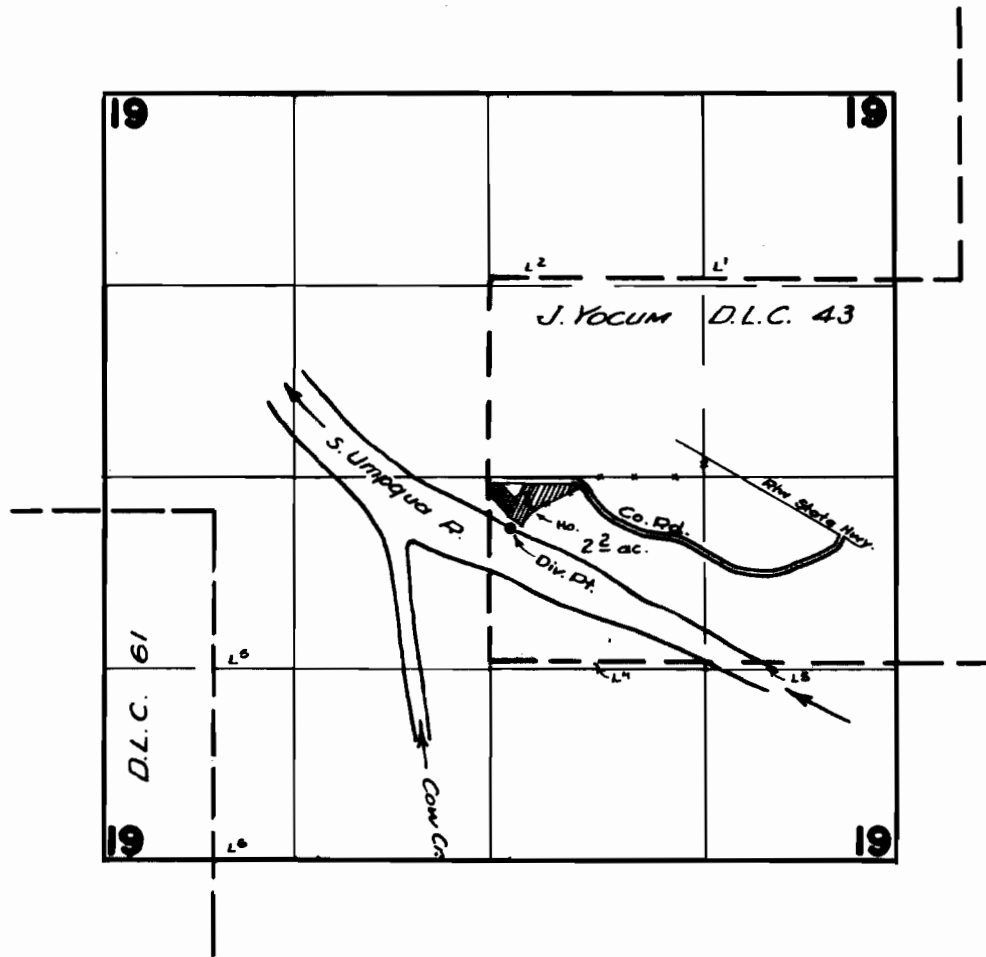

**FINAL PROOF SURVEY**  
UNDER

Application No. 31923 Permit No. 25171  
IN NAME OF

EMMETT L. CROWLEY

Surveyed JUNE 15 1961, by M. B. Bish