


T.32S.R.4W.W.M.

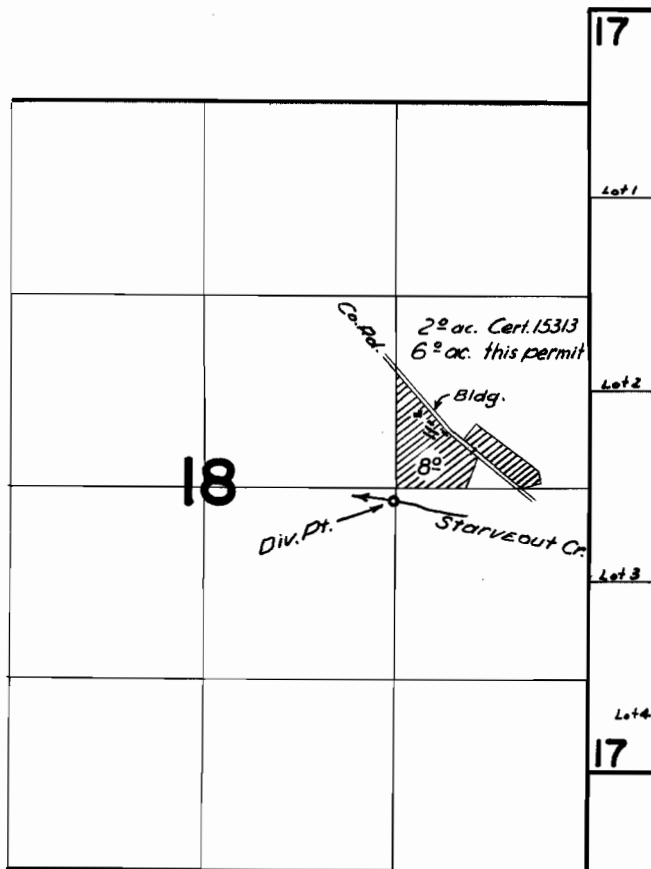

FINAL PROOF SURVEY
UNDER

Application No. 31797 Permit No. 25197
IN NAME OF

BEN F. & CLARA MAE PHELPS

Surveyed 2 MAY 1961, by M. Bish