


T. 30S. R. 5 W. W.M.

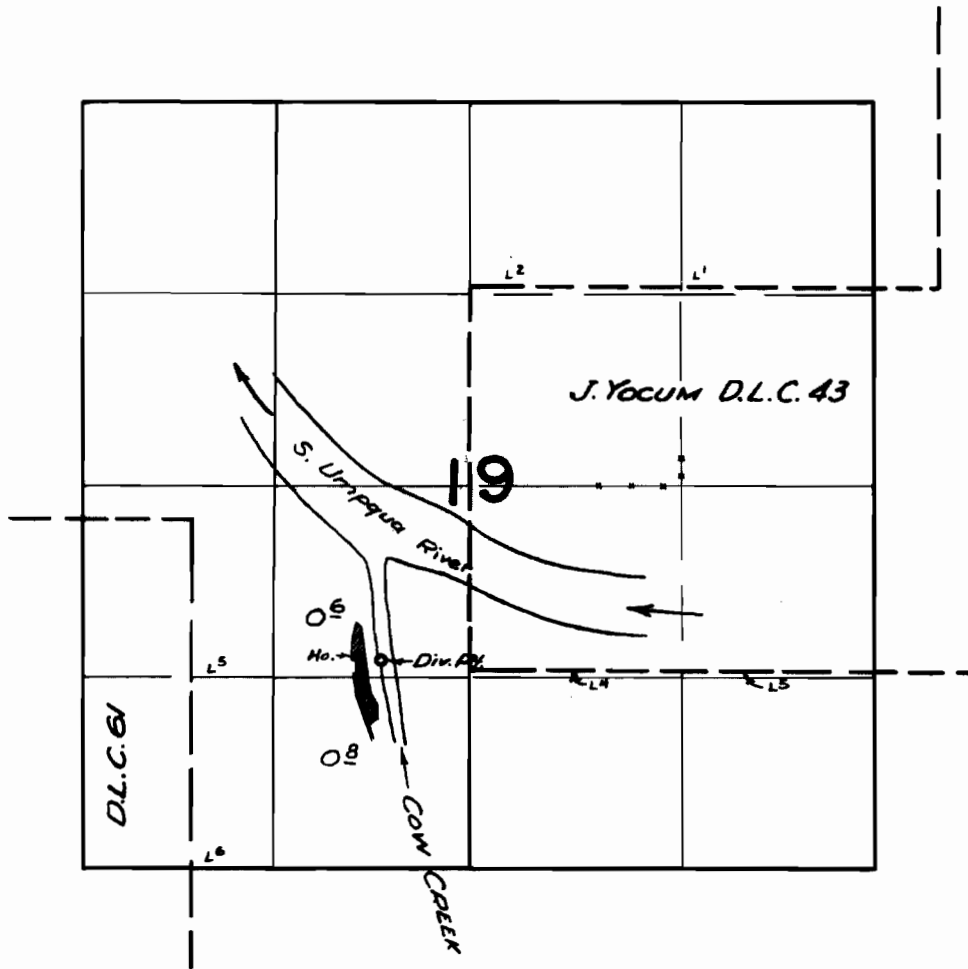

FINAL PROOF SURVEY
UNDER

Application No. 31974 Permit No. 25238
IN NAME OF

WILLIAM B. & ELAINE M. STROBRIDGE

Surveyed MAY 4 1961, by M. B. Bish