


T.29S.R.5W.W.M.

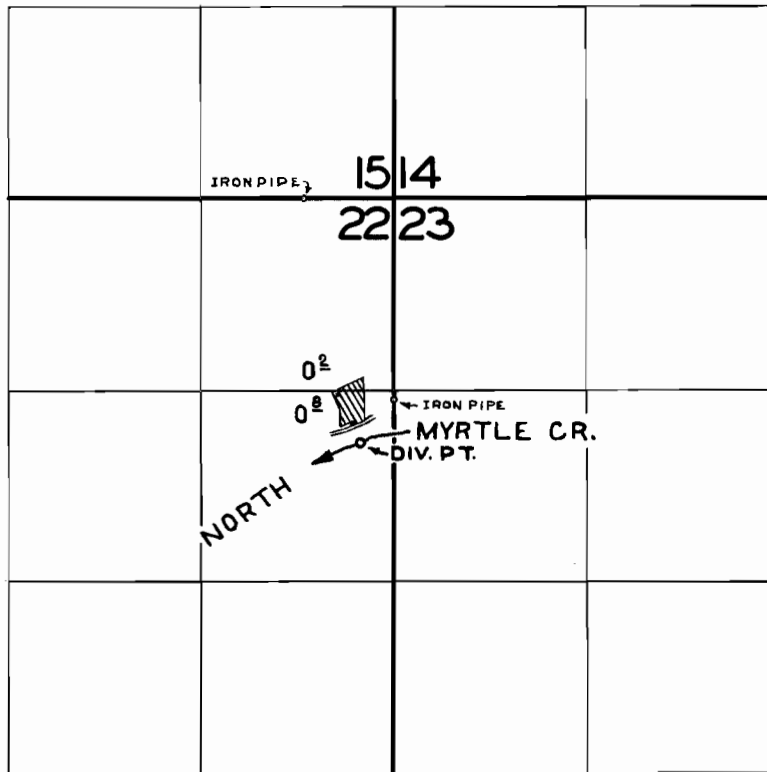

FINAL PROOF SURVEY
UNDER

Application No. 32847. Permit No. 26003...
IN NAME OF

.....
Surveyed MAY 5 1961, by C.O. BARTELS.