


# T.32S.R.6 W.W.M.

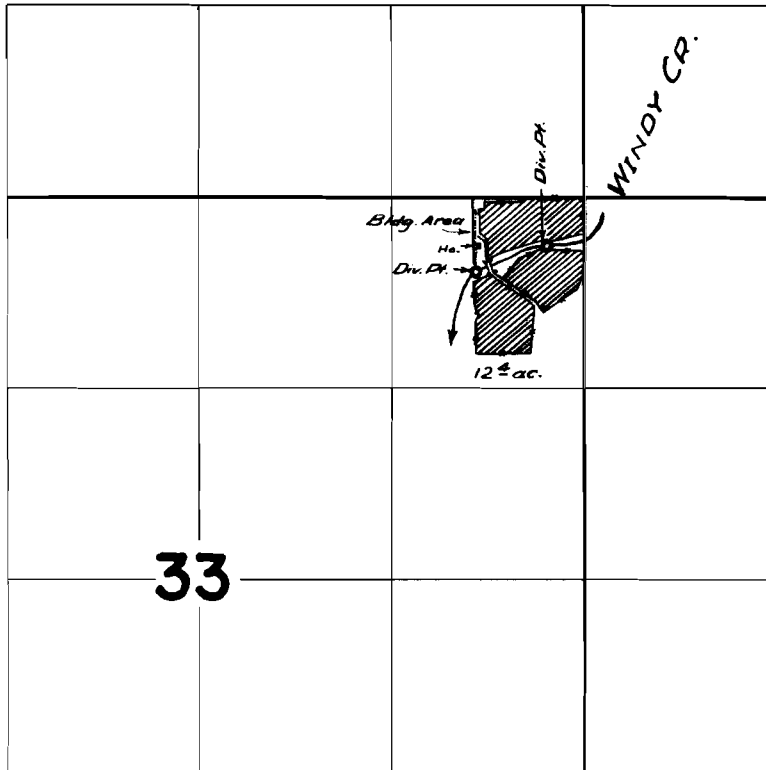

33

## FINAL PROOF SURVEY UNDER

Application No. 33581 Permit No. 26565  
IN NAME OF

C.H. & JOYCE A. PEIL

Surveyed 3 MAY 1961, by M. Bish