


T.37S. R.1E.W.M.

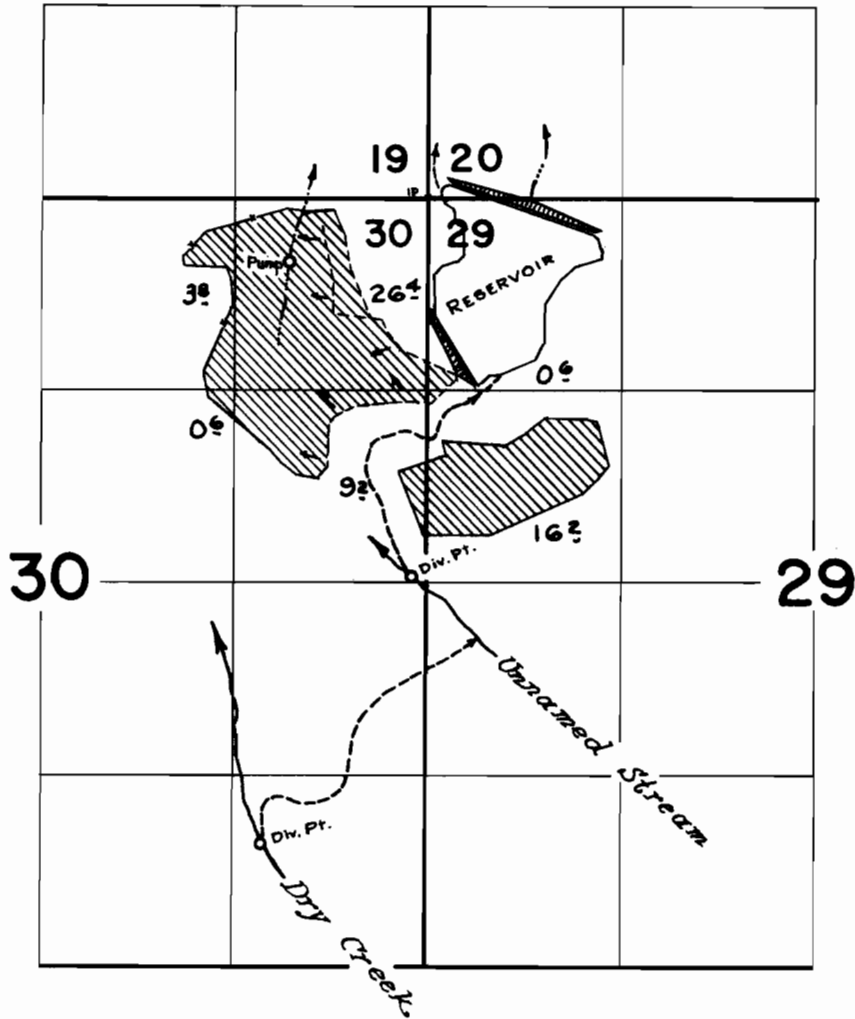

FINAL PROOF SURVEY UNDER

Application No. **R-17459** ~~18758~~ Permit No. **R-746** ~~14363~~
IN NAME OF

W. V. JOHNSTON & DOUGLAS PLUMLEY

Surveyed *April 15 1961*, by *R. H. Johnson*