


T.37S. R.1E.W.M.

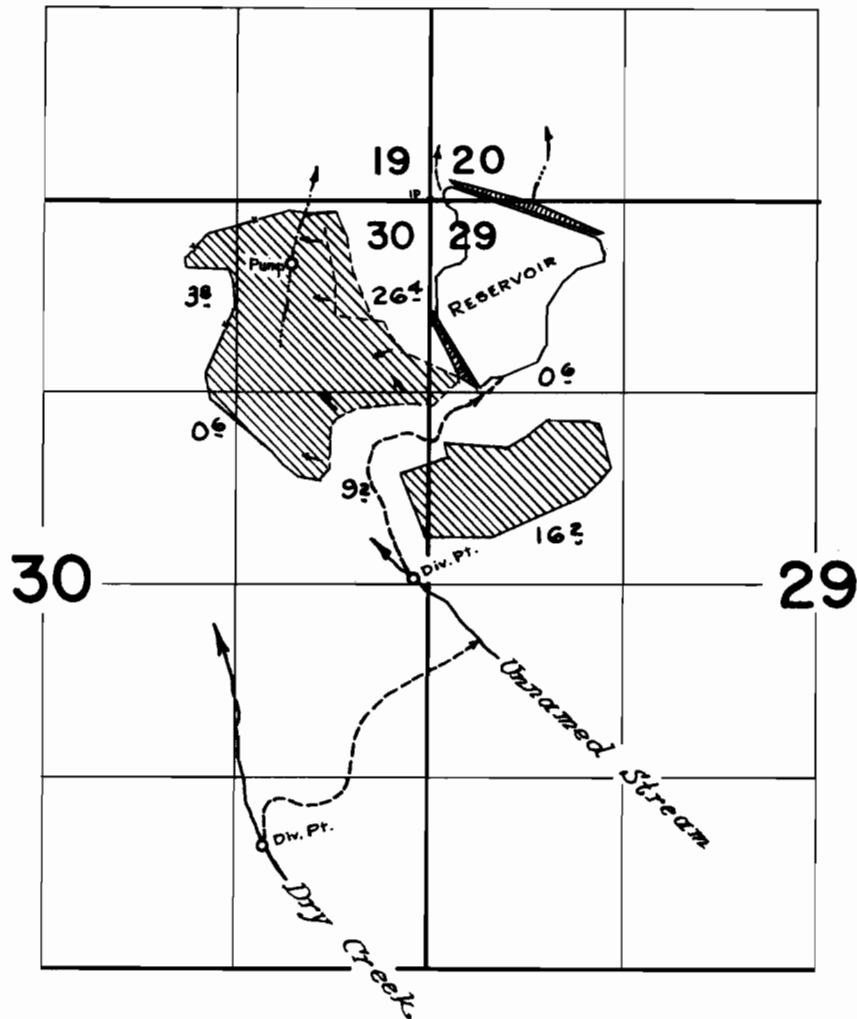

**FINAL PROOF SURVEY**  
UNDER

R-17459 R-746  
Application No. 18758 Permit No. 14363  
IN NAME OF

**W.V. JOHNSTON & DOUGLAS PLUMLEY**

Surveyed April 15 1961, by *R. H. Jackson*