


T. 36 S. R. 2 W. W.M.

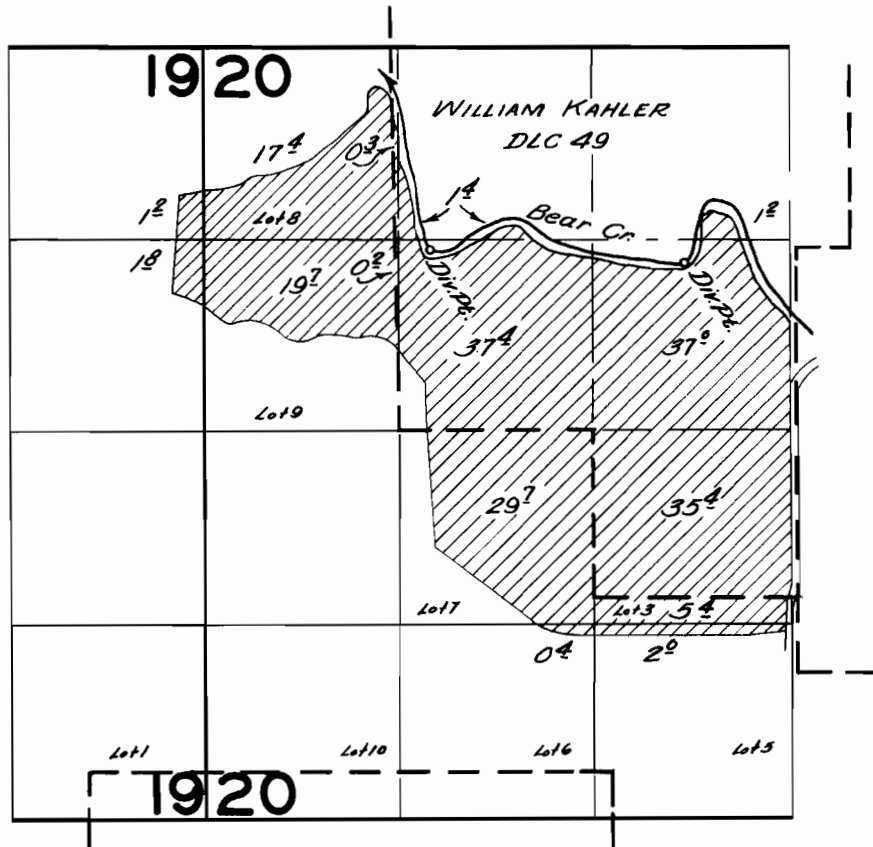


**FINAL PROOF SURVEY**  
UNDER

Application No. 24461. Permit No. 19282.  
IN NAME OF

*T. R. PARKER*

Surveyed April 13 1960, by *Coartel*

T.36S. R.2W.W.M.

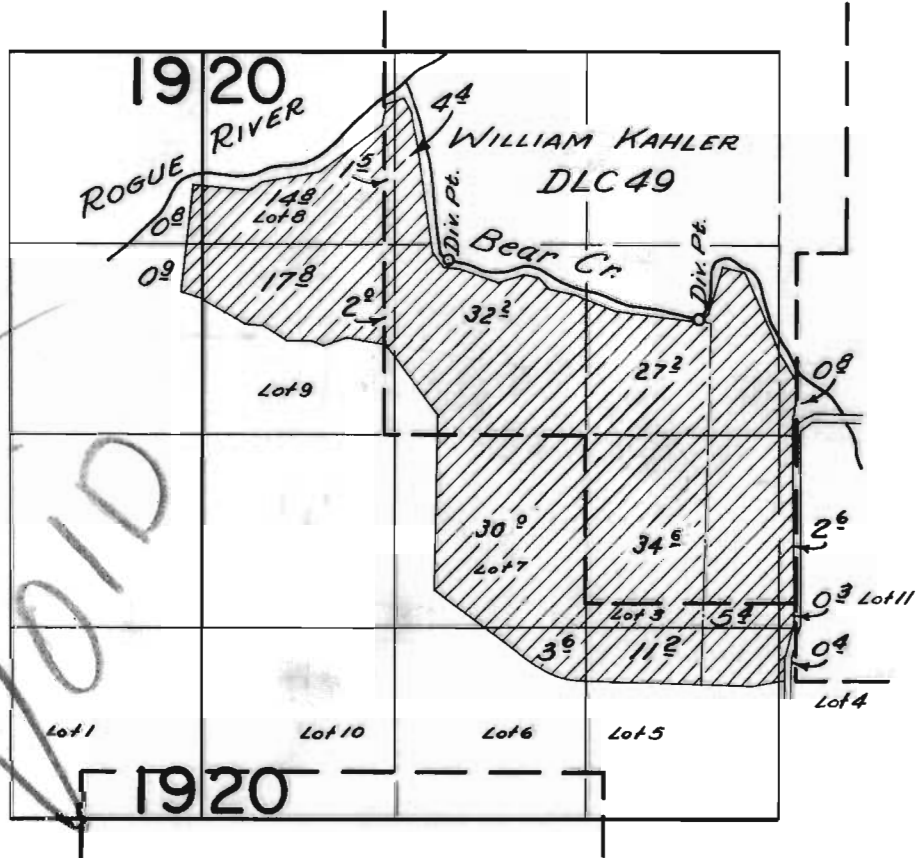

**FINAL PROOF SURVEY**  
UNDER

Application No. 24461... Permit No. 19282...  
IN NAME OF

*T. R. PARKER*

Surveyed *April 13, 1960*, by *C. D. Bartsch*