


T. 33 S., R. 2 E., W.M.

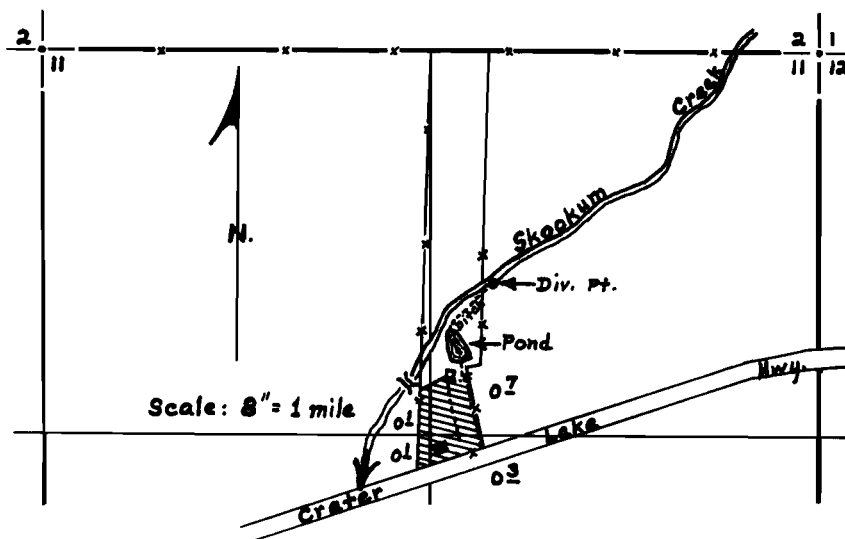

FINAL PROOF SURVEY UNDER

RECEIVED
JAN 24 1962
STATE ENGINEER
SALEM, OREGON

Application No. 32310 Permit No. 25500
IN NAME OF

Warren L. & Yelda R. Barr
Nov. 14, 1961
Surveyed Jan. 11, 1962, by D. L. Hendrix