


T. 38 S. R. 8 W. W. M.

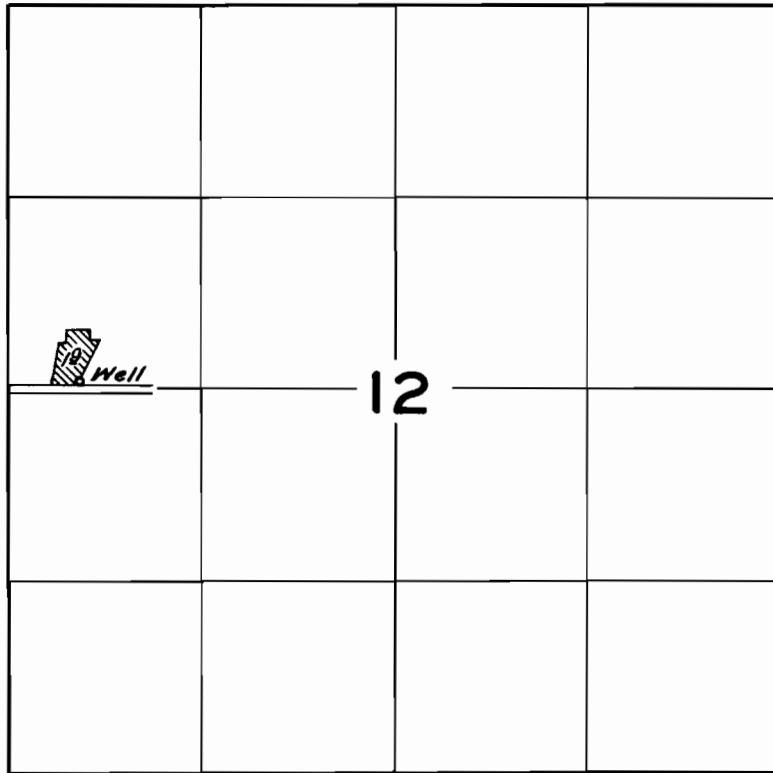

**FINAL PROOF SURVEY**  
UNDER

Application No. *Q-1763* Permit No. *Q-1629*  
IN NAME OF

*FRITZ KRAUSS*

Surveyed *April 20 1961*, by *Chas. Smith*