


T.36S.R.5W.W.M.

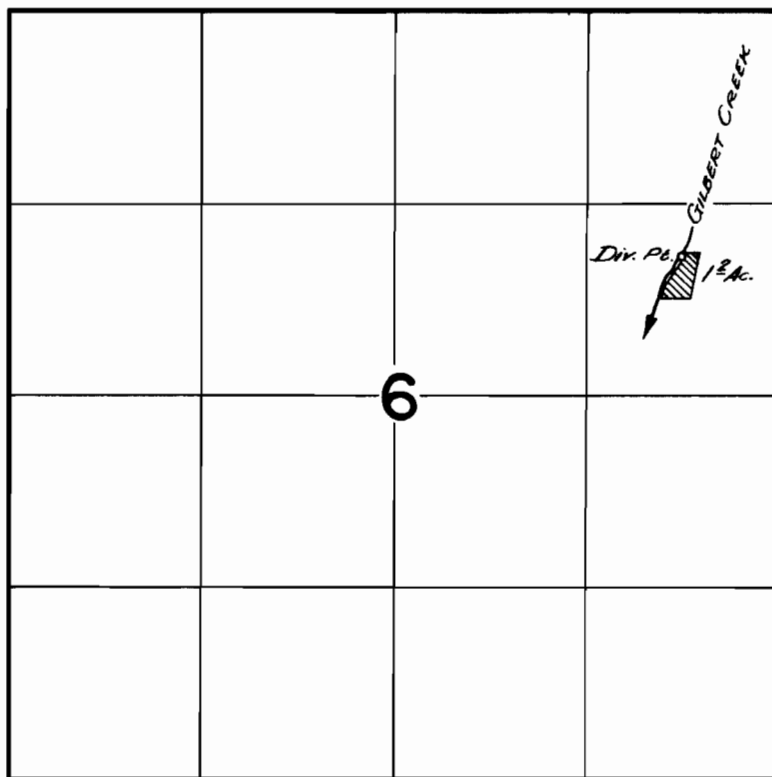

FINAL PROOF SURVEY
UNDER

Application No. 28982 Permit No. 22789
IN NAME OF

FRANK J. BLATTNER

Surveyed APRIL 15 1961, by Chantel