


T.39S.R.8W.W.M.

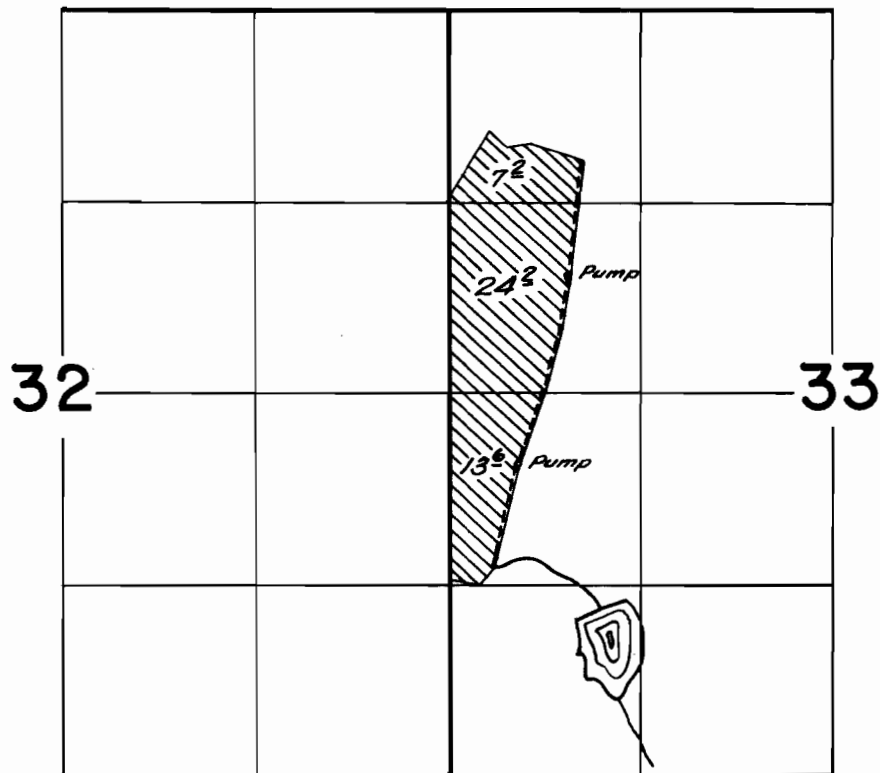

FINAL PROOF SURVEY
UNDER

Application No. R-33159 33160 Permit No. R-2308 26485
IN NAME OF

DONALD W. ROSENBERG

Surveyed April 12, 1961, by C. B. Smith