


U-402  
29619

# T. 38S. R. 11 1/2 E. W.M.

Swan Lake Wells

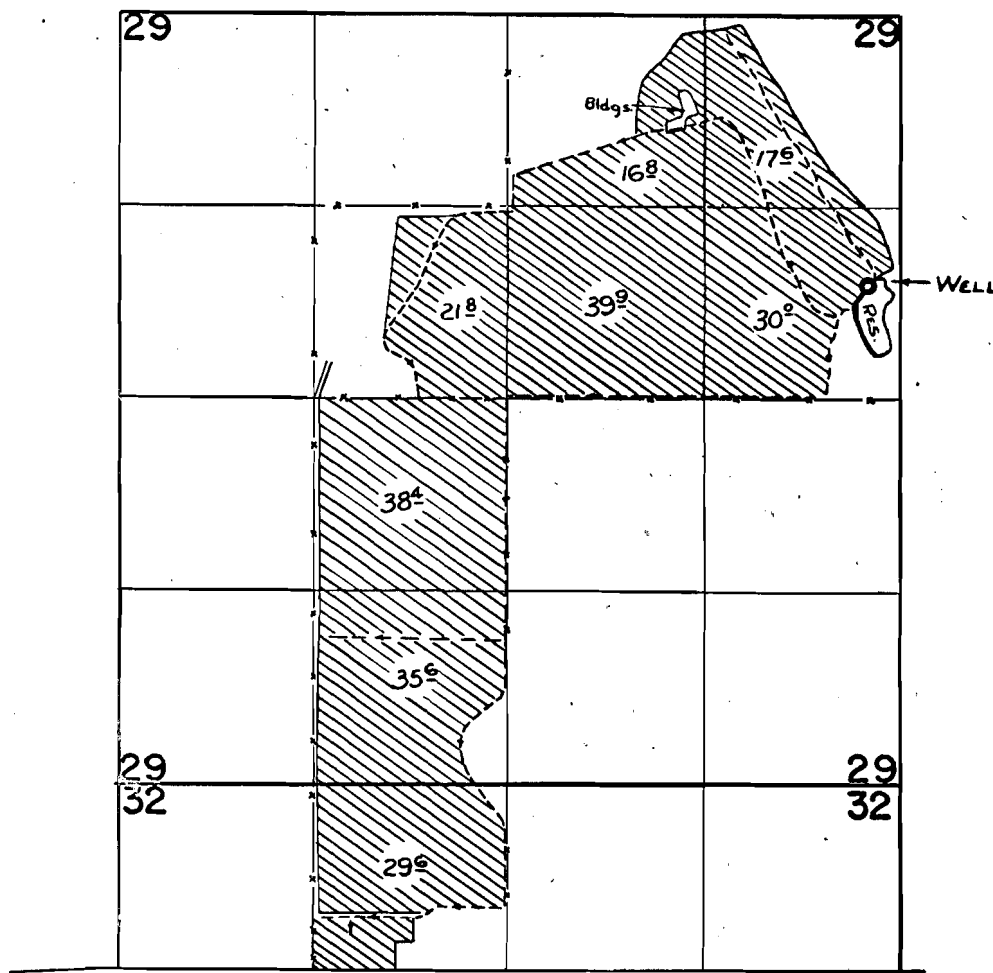

## FINAL PROOF SURVEY UNDER

Application No. U-318 Permit No. U-402  
IN NAME OF

LLOYD L. HANKINS & L. M. HANKINS.

Surveyed 13 APRIL 1961, by M. Bish