


T. 37 & 38 S. R. 11 1/2 E. W. M.

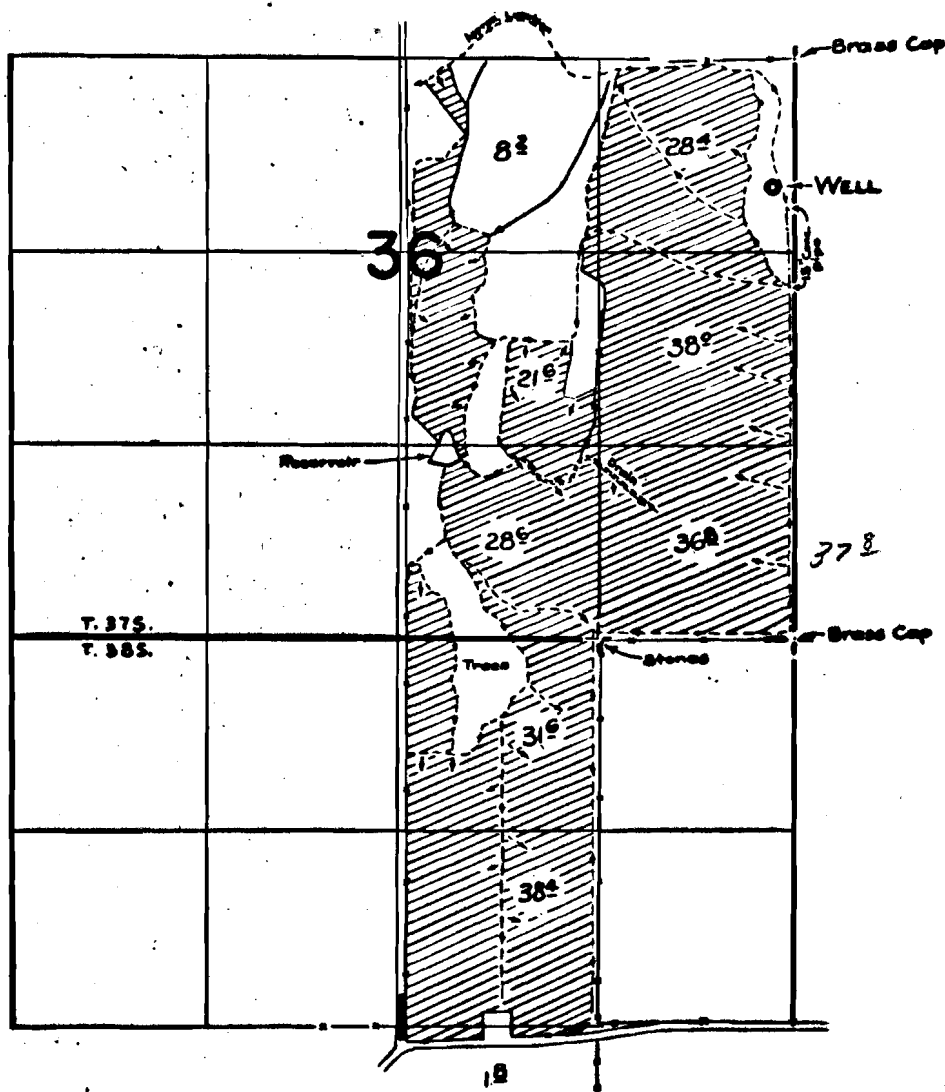

FINAL PROOF SURVEY UNDER

Application No. U-456 Permit No. U-563
IN NAME OF

DONALD E. & VIRGINIA H. SCHREINER

Surveyed 14 JULY 1961, by M. A. Bish