


T.38S.R.11E.W.M.

Buck Creek Valley wells

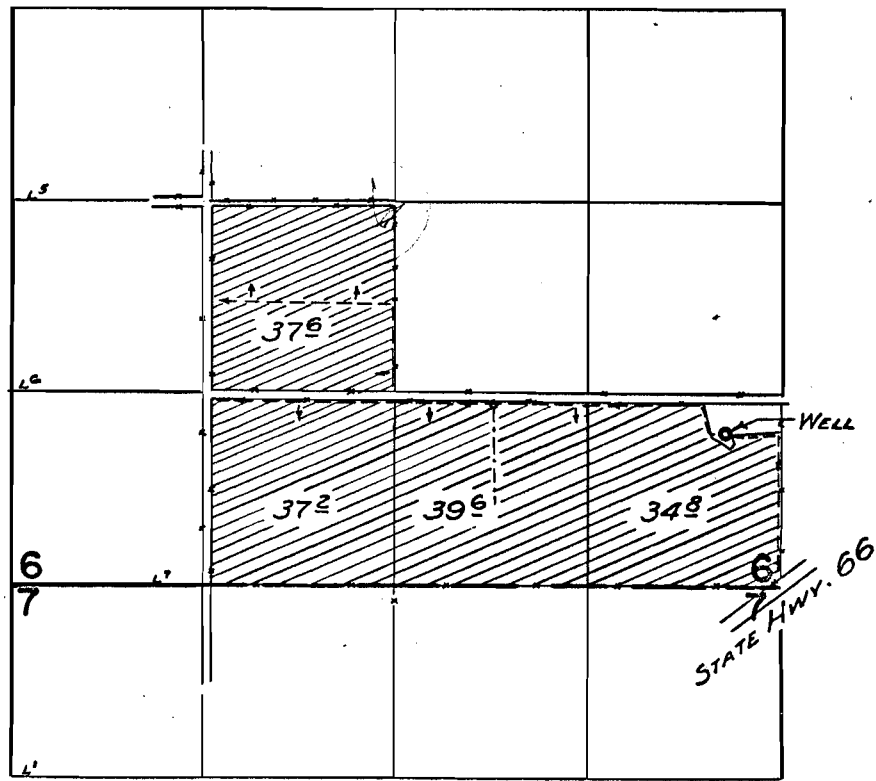

FINAL PROOF SURVEY UNDER

Application No. U-465 Permit No. U-566
IN NAME OF

JOHN HARTZLER

Surveyed 12 APRIL 1961, by M. Bish