


T.38S.R.11E.W.M.

Back Cr. & Yuma Valley wells

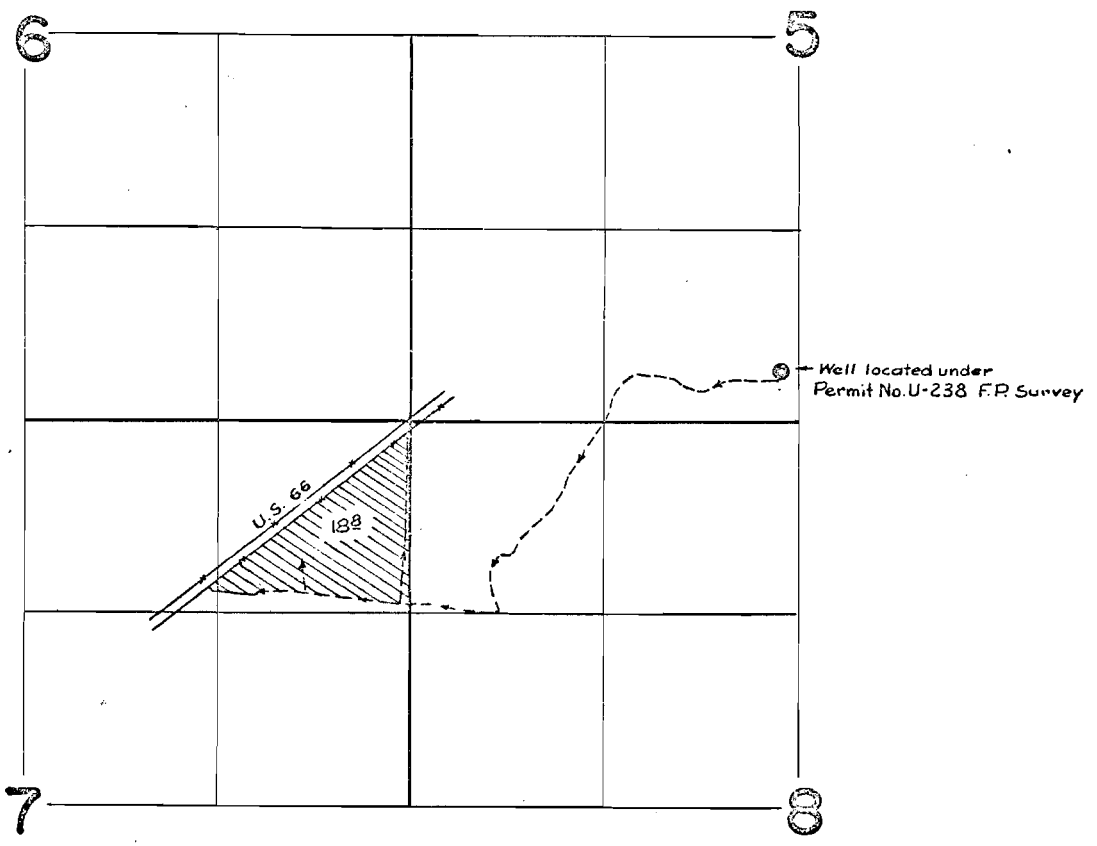

FINAL PROOF SURVEY UNDER

Application No. G-927 Permit No. G809
IN NAME OF

LEONARD G. PITTER

Surveyed 11 APRIL 1961, by M. Bish