


T. 39 S. R. 11 E. W.M.

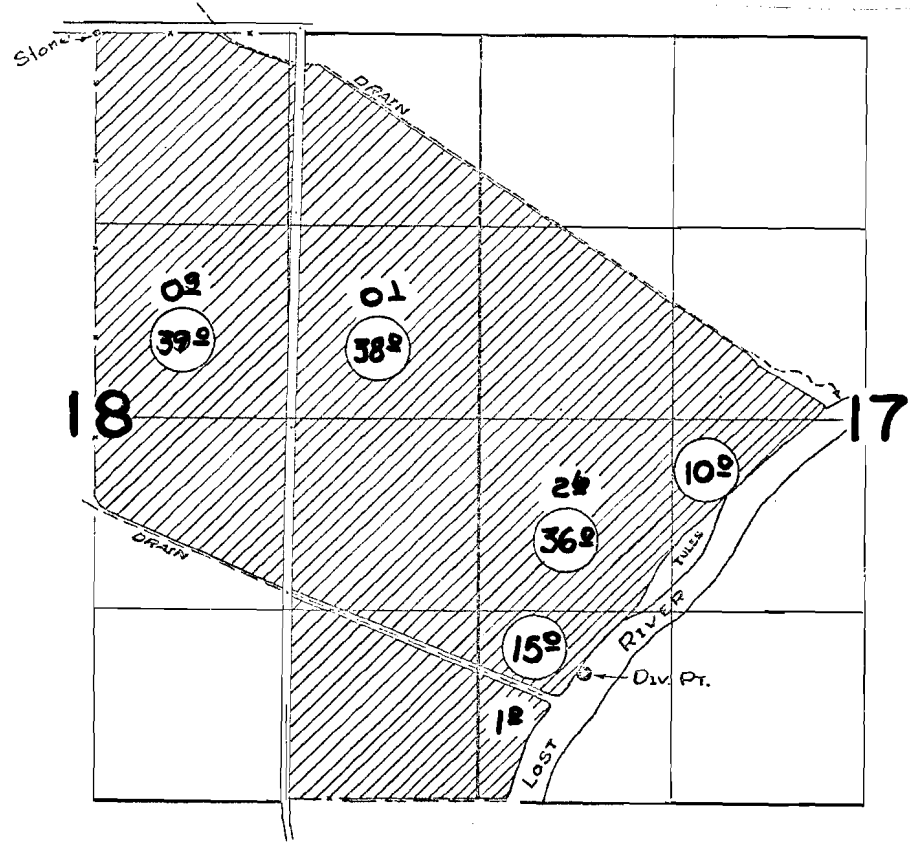

Lost River

FINAL PROOF SURVEY UNDER

EXISTING RIGHTS

Application No. 27045 Permit No. 21283
IN NAME OF

ROY T. & MARGARET ANN WHITLATCH

Surveyed APRIL 11, 1961, by M. Reh