


23230
29625

T.32 S.R.8 E.W.M.

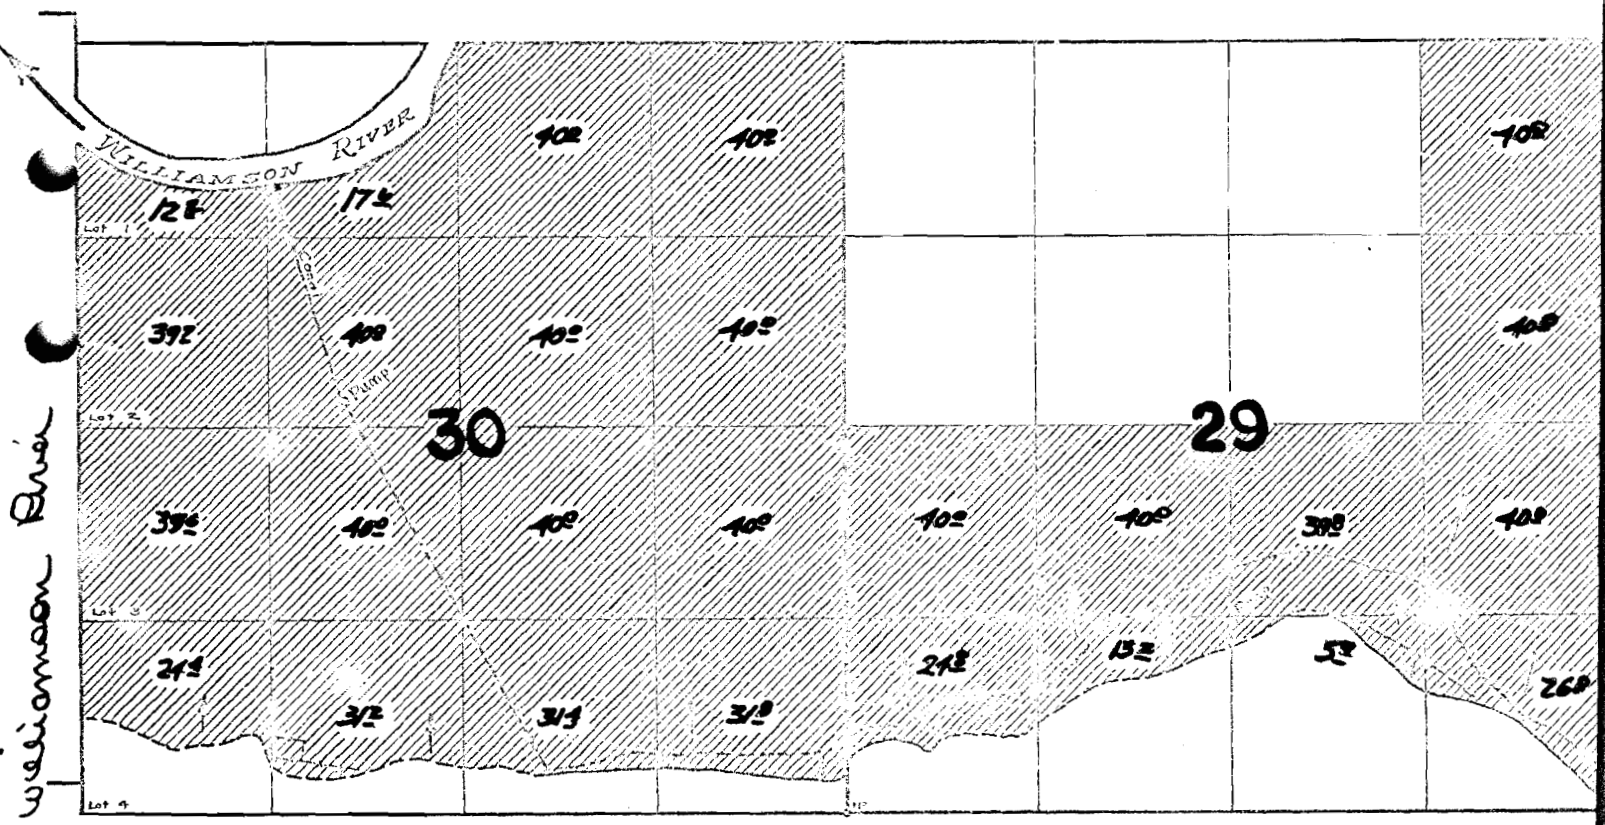

Williamson River

FINAL PROOF SURVEY UNDER

Application No. 28949 Permit No. 23230
IN NAME OF

BEN C. GERWICK % JAMES C. MILLER JR.

Surveyed June 14, 1961 by R.H. Jackson