


T. 34&35 S. R. 12 E. W. M.

Sycan R. below Sycan marsh

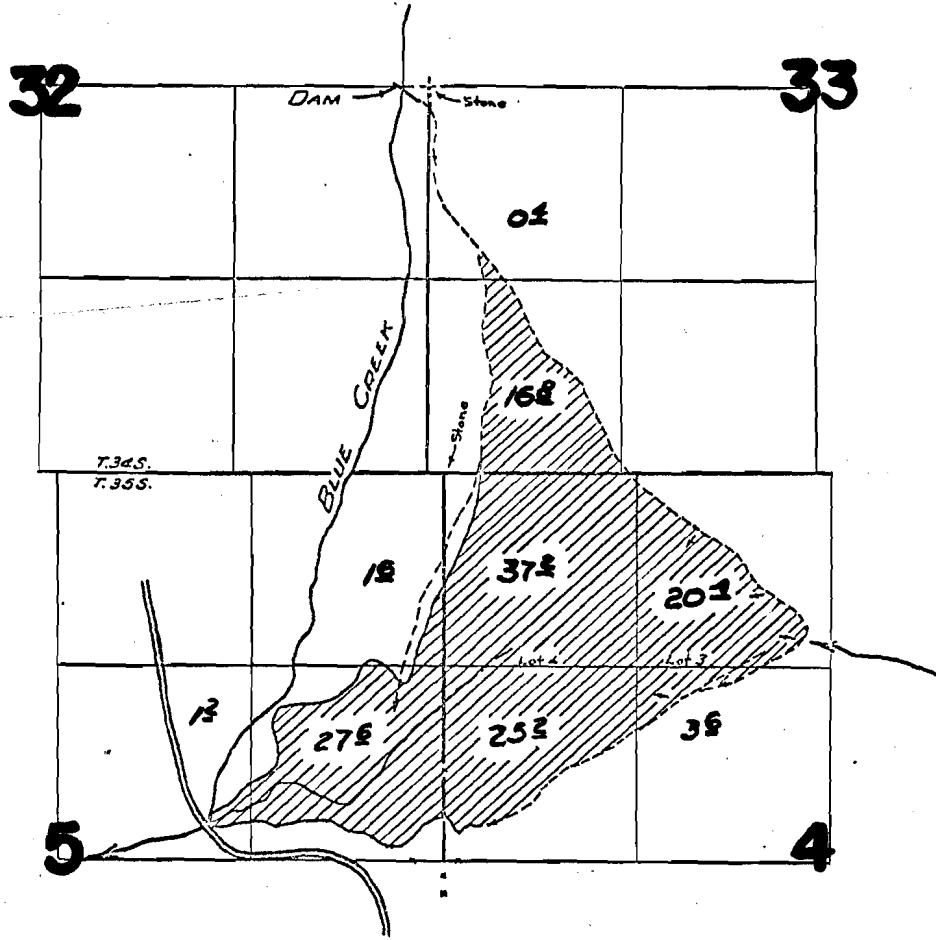

FINAL PROOF SURVEY UNDER

Application No. 31777... Permit No. 25089...
IN NAME OF

JAY A. FAIRCLO

Surveyed 17 July 1961, by M. Beh