


# T.41 S.R.14½ & 15 E.W.M.

Rock Cbk. & Misc.

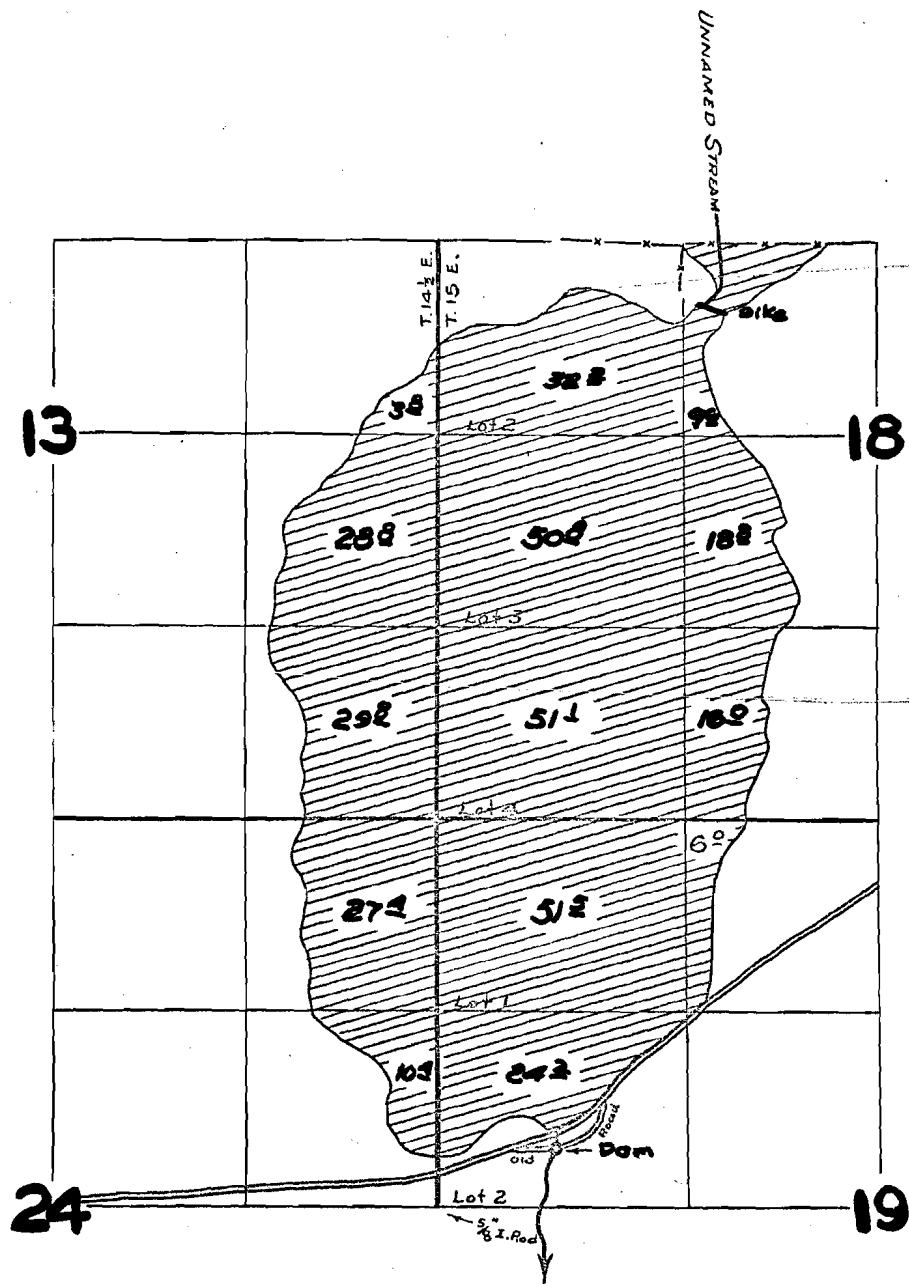

## FINAL PROOF SURVEY

UNDER

Application No. 32048, Permit No. 25292

IN NAME OF

**CHARLES & SILAS W. KILGORE and LOUISE KILGORE**

Surveyed 6 Oct. 1959, by Tom Bish