


T.36S.R.12E.W.M.

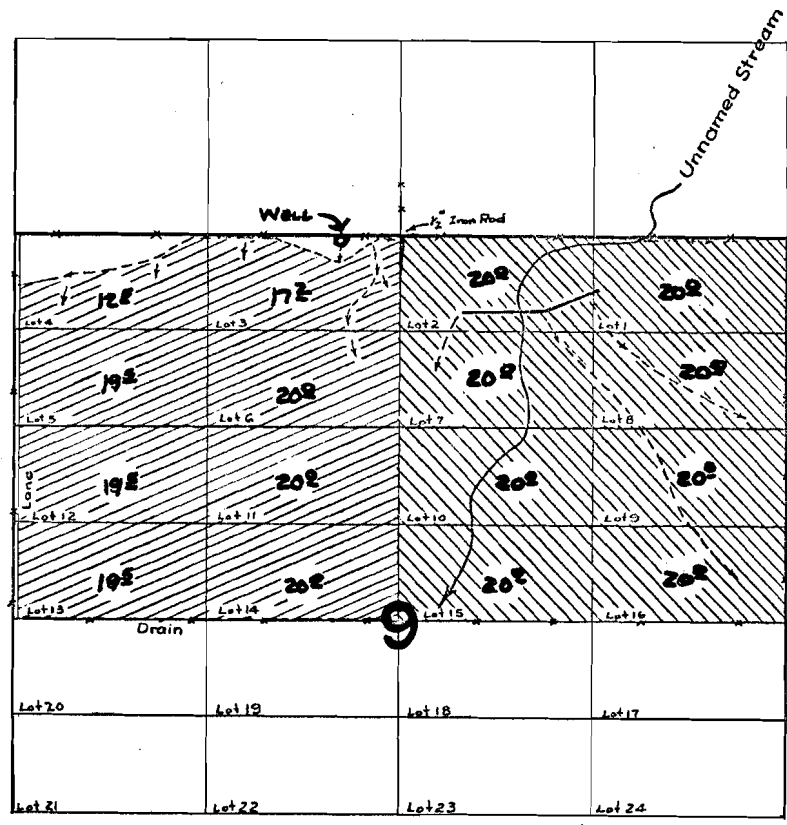

FINAL PROOF SURVEY UNDER

G-444 G-368
Application No. 32133 Permit No. 25518
IN NAME OF

L.L. CRAWFORD

Surveyed 15 JULY 1961, by M. Bick

Sprague River Meas.