


T.18S.R. 3W.W.M.

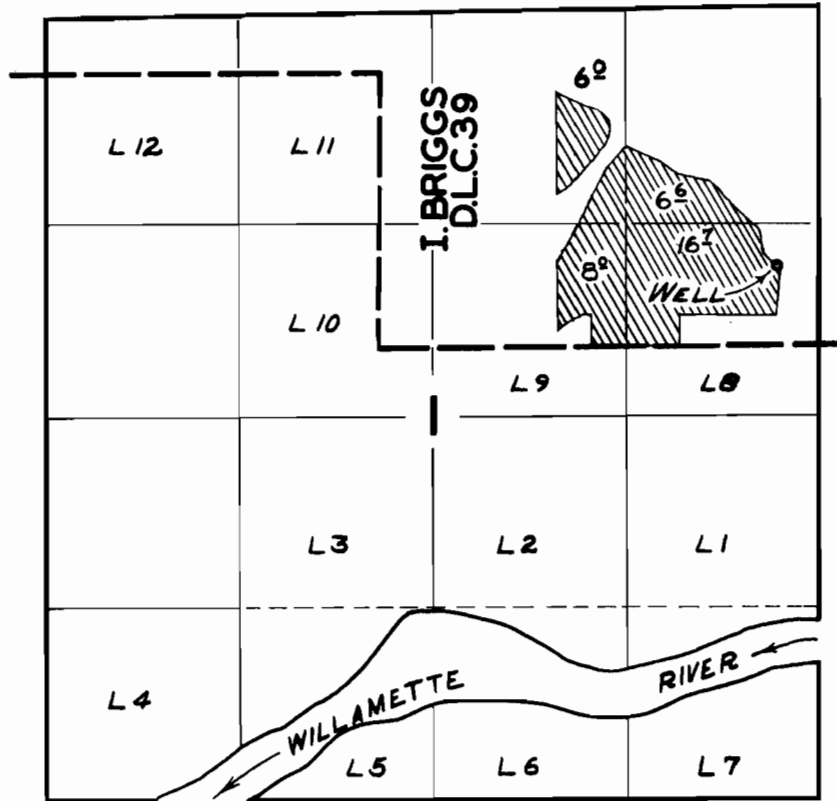

FINAL PROOF SURVEY
UNDER

Application No. G-897..... Permit No. G-726.....
IN NAME OF

.....DONALD V. SAUL.....

Surveyed *May 23, 1961*, by *C.O. BARTELS*.....