


T.17S.R.1 E.W.M.

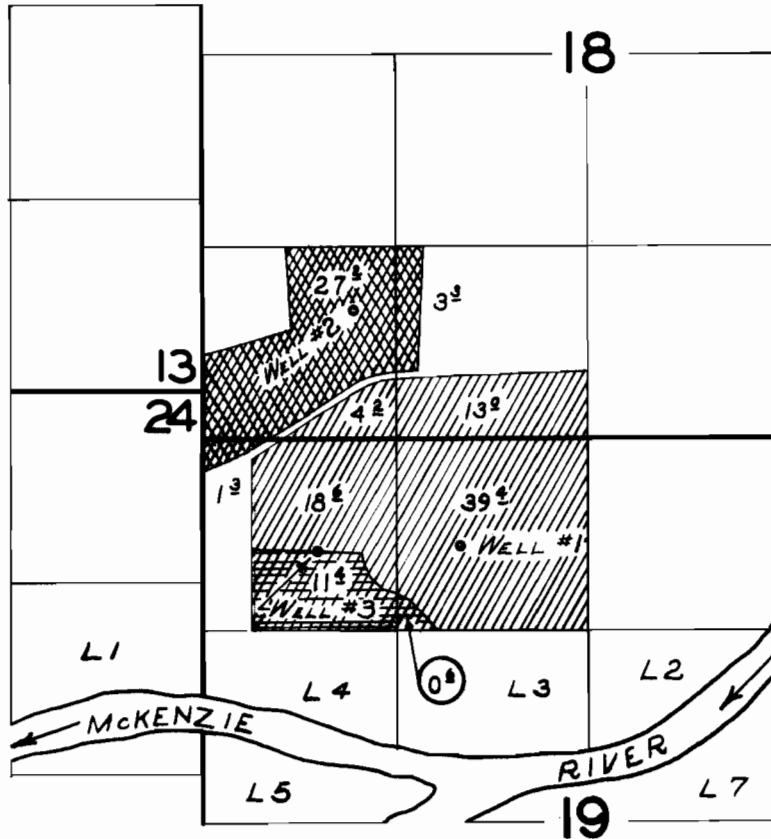

WELL #1
 WELL #2
 WELL #3

FINAL PROOF SURVEY
 UNDER

Application No. *G-1725* Permit No. *G-1579*
 IN NAME OF

RICHARD & ILY HART

Surveyed *MAY 24* 19.61, by *C.O. BARTALS*