


T.18S.R.5W.W.M.

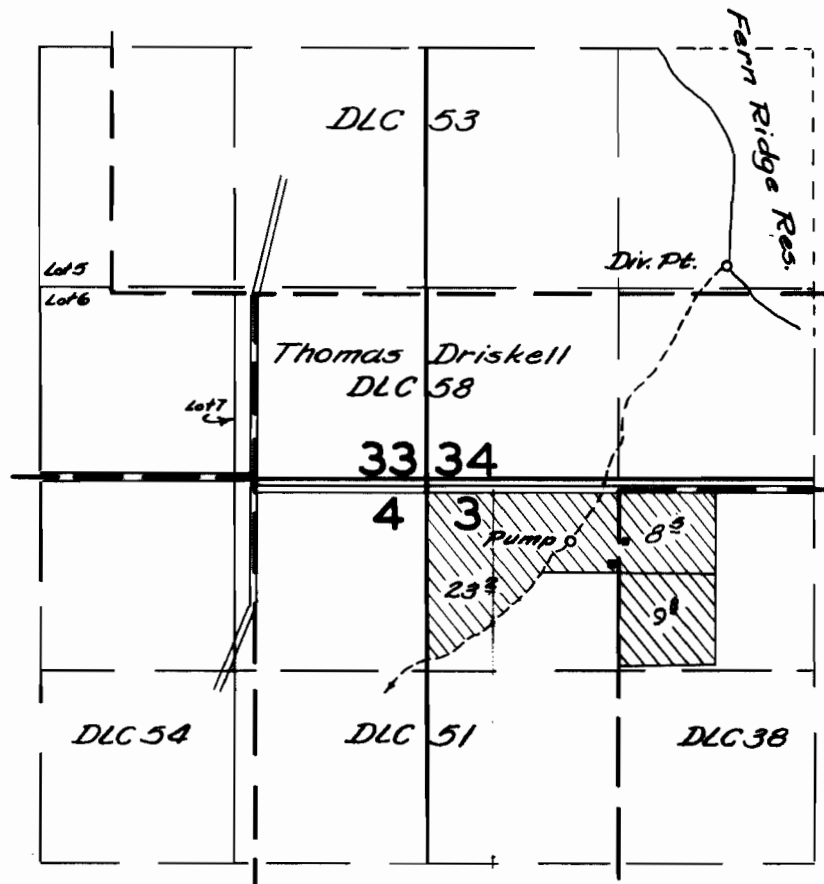

FINAL PROOF SURVEY
UNDER

Application No. 29431 Permit No. 23037
IN NAME OF

LENNIE HALDORSON

Surveyed April 27 1960, by C.O. Barseis
May 10 1961 C.O. Barseis