


T.17S.R.2W.W.M.

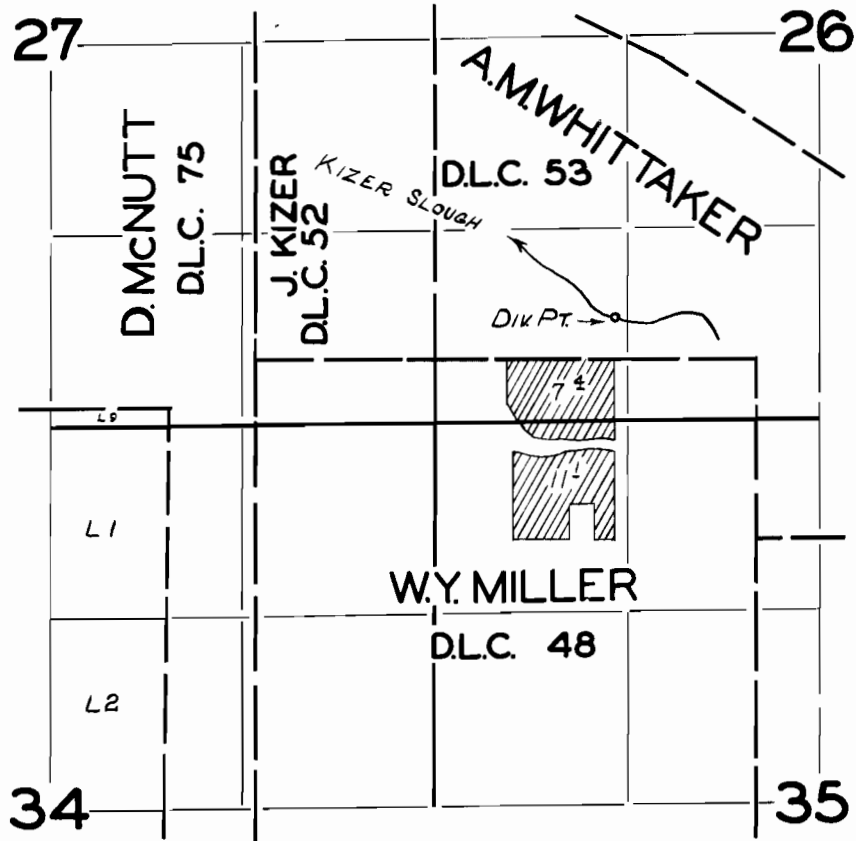

FINAL PROOF SURVEY
UNDER

Application No. 3/7/3 ... Permit No. 25081 ...
IN NAME OF

KENNETH & ROY PLATT

Surveyed *MAY 25* 1961, by *C.O. BARTELS*