


T.17S.R. 5W.W.M.

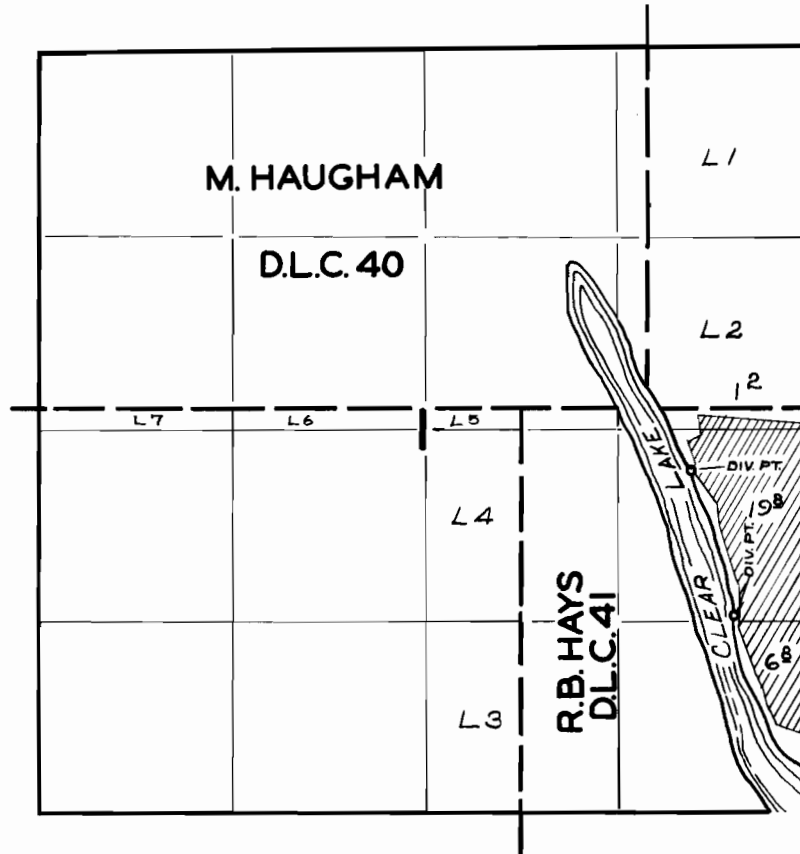

FINAL PROOF SURVEY
UNDER

Application No. 317.78... Permit No. 25090..
IN NAME OF

.....*ROOSEVELT MACAULEY*.....

Surveyed *MAY 8*..... 1961, by *C.O. BARTELS*..