


# T.19S.R.2W.W.M.

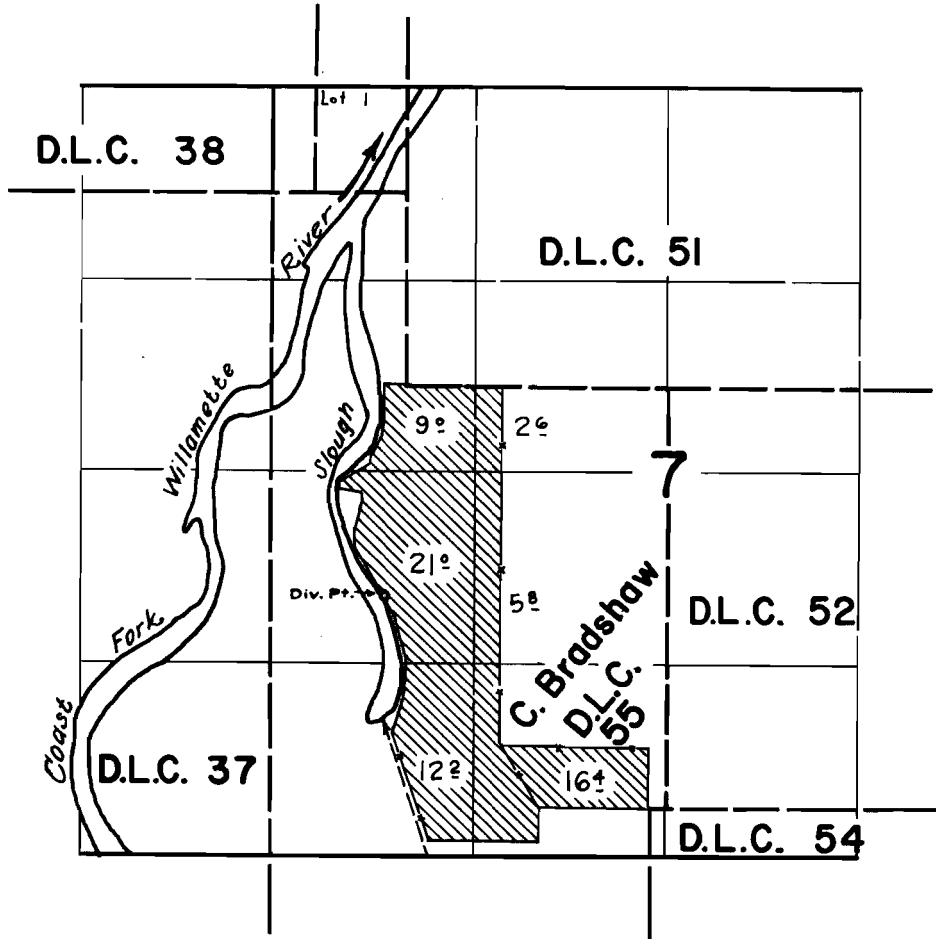

## FINAL PROOF SURVEY UNDER

Application No. 32040.. Permit No. 25272...  
IN NAME OF

**KENNETH & WALTER DANSTROM**

Surveyed May 25, 1961., by *[Signature]*