


T.18S.R. 3W.W.M.

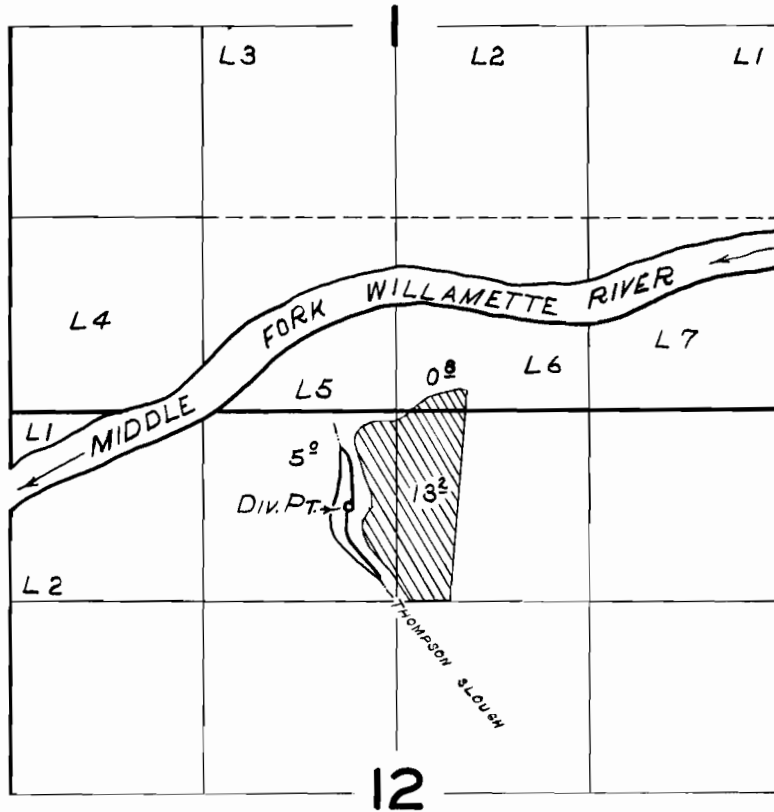

FINAL PROOF SURVEY
UNDER

Application No. 32229 . Permit No. 254.77 .
IN NAME OF

JULIO W. & ELIZABETH M. SILVA

Surveyed *MAY 11* . 1961 , by *G.O. BARTELS* . . .