


T.18S.R.10W.W.M.

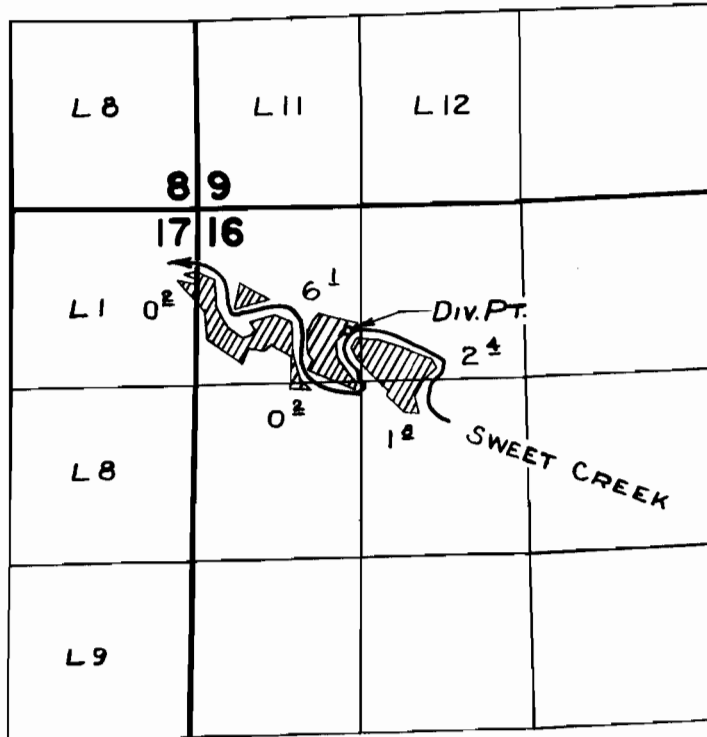

**FINAL PROOF SURVEY**  
UNDER

Application No. 32733... Permit No. 25842...  
IN NAME OF

.....WILSON B. CAREY.....

Surveyed JUNE 7, 1961, by C.O. BARTELS.