
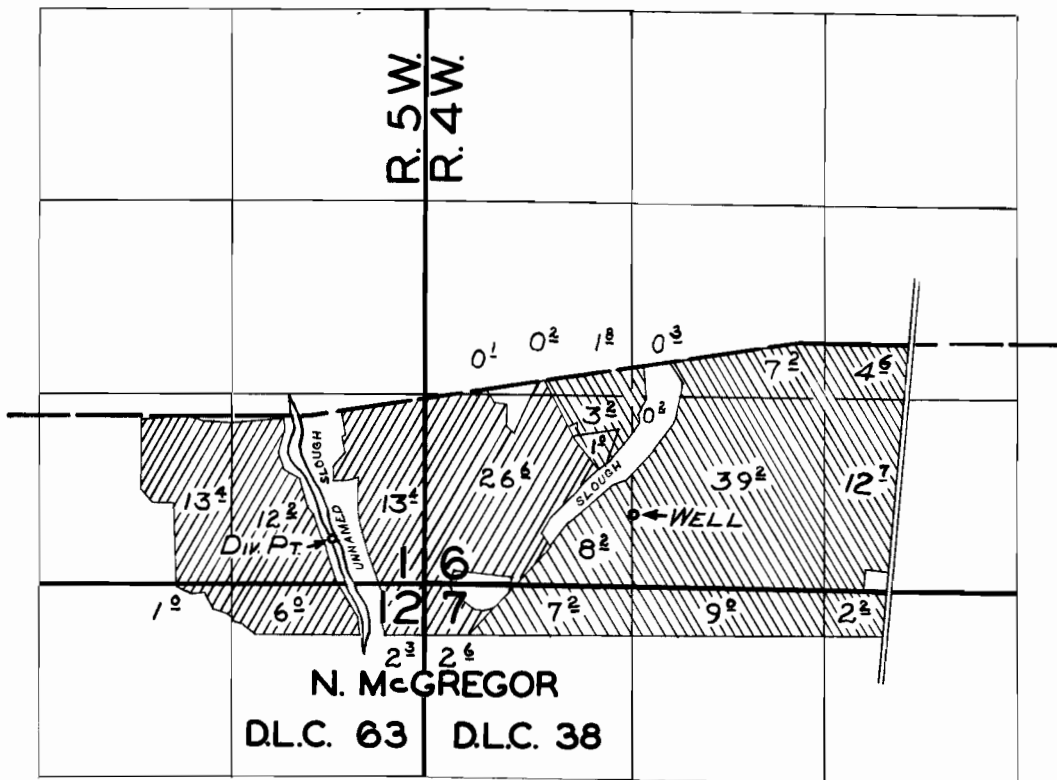


T.14S.R.4&5W.W.M.

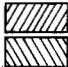

FINAL PROOF SURVEY UNDER

Application No. 31444 24799
 G-585 Permit No. G-526 
 IN NAME OF

A. J. & J. VAN DE POL VAN LEEUWEN

Surveyed *JUNE 20 1961*, by *M. BISH*.....