
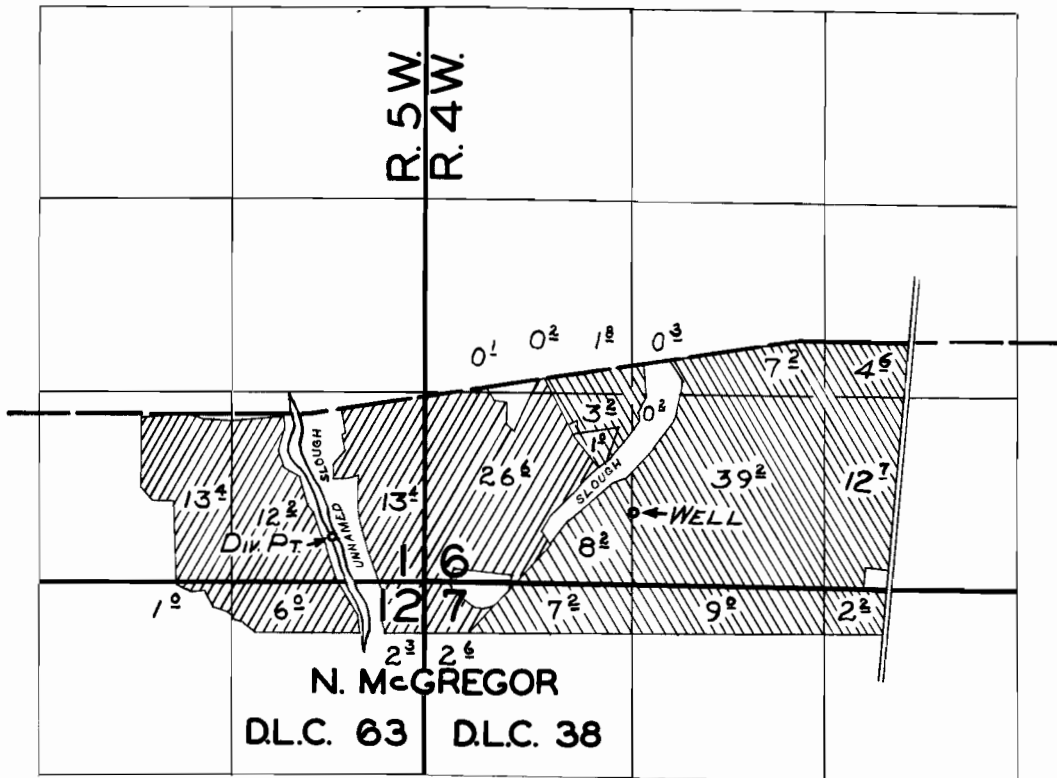


# T.14S.R.4&5W.W.M.

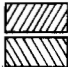

## FINAL PROOF SURVEY UNDER

Application No. 31444 ..... Permit No. 24799 .....   
 G-585 ..... G-526 .....  
 IN NAME OF

**A. J. & J. VAN DE POL VAN LEEUWEN**

Surveyed *JUNE 20 1961*, by *M. BISH*.....