


T.18S. R. 47E.W.M.

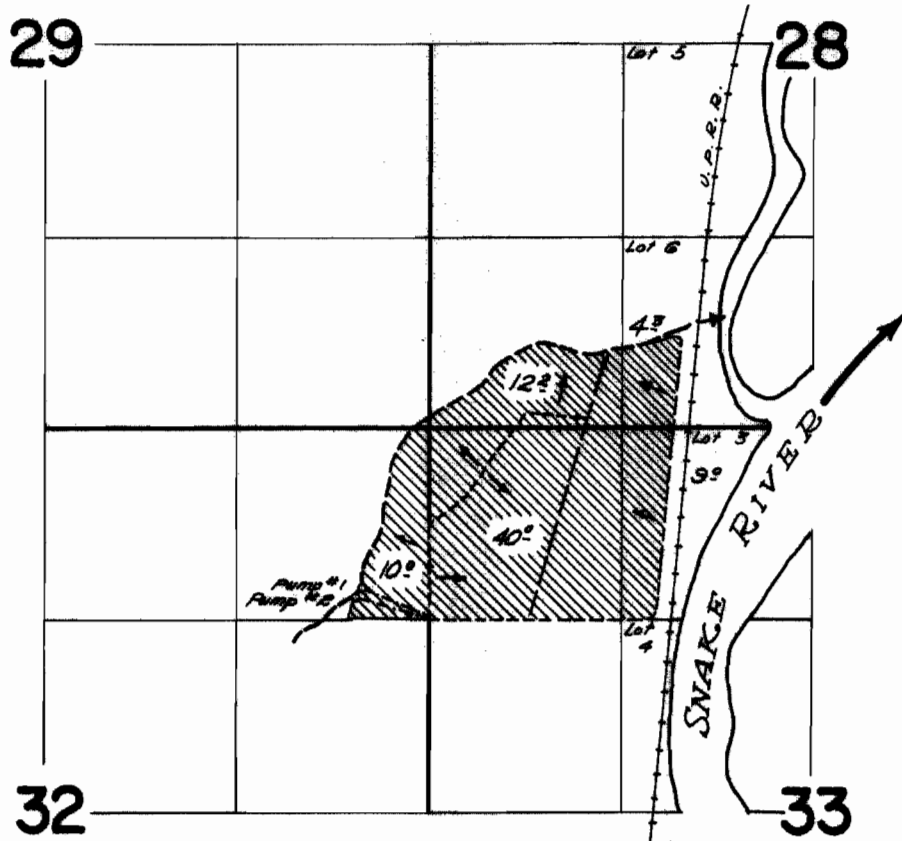

FINAL PROOF SURVEY
UNDER

Application No. 34155 Permit No. 26994
IN NAME OF

FRANKIE OET

Surveyed Oct. 19 1961, by R. J. Johnson