


T.9S.R.1W.W.M.

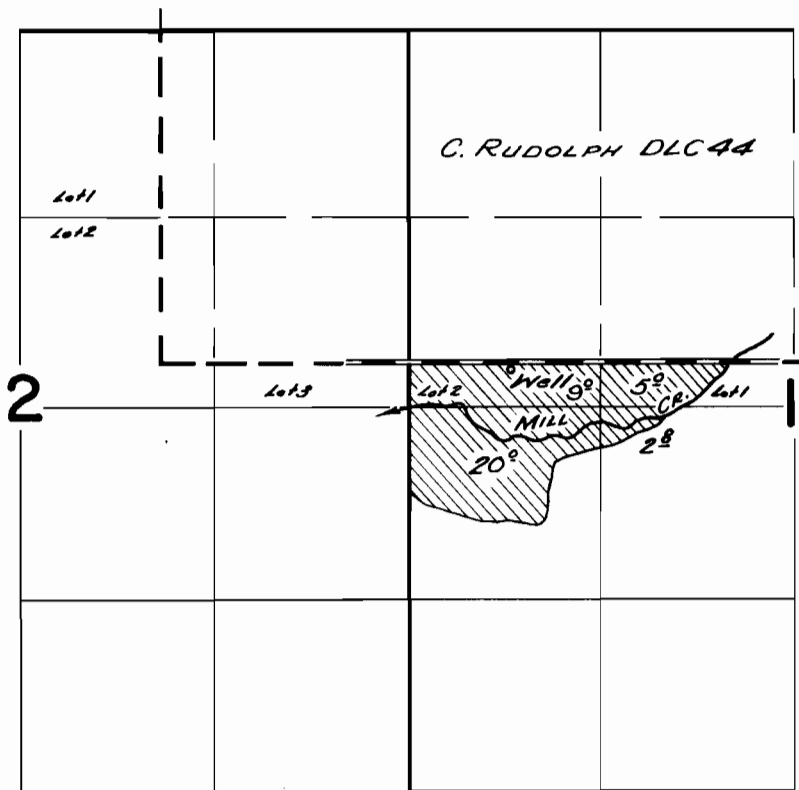

FINAL PROOF SURVEY UNDER

Application No. *G-852* Permit No. *G-754*
IN NAME OF

ETZEL BROS.

Surveyed *April 22 1961*, by *C.D. Burt*