


T.6S.R.1E.W.M.

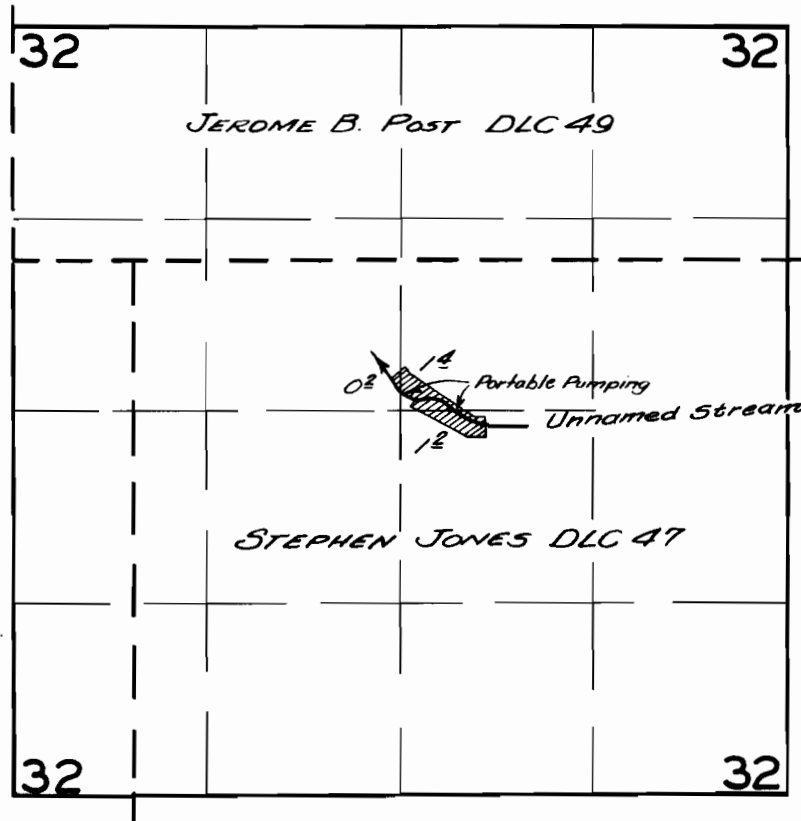

FINAL PROOF SURVEY
UNDER

Application No. 27385 Permit No. 22882
IN NAME OF

OSCAR LOE

Surveyed OCT. 23 1961, by COBEN