


T.8S.R.2W.W.M.

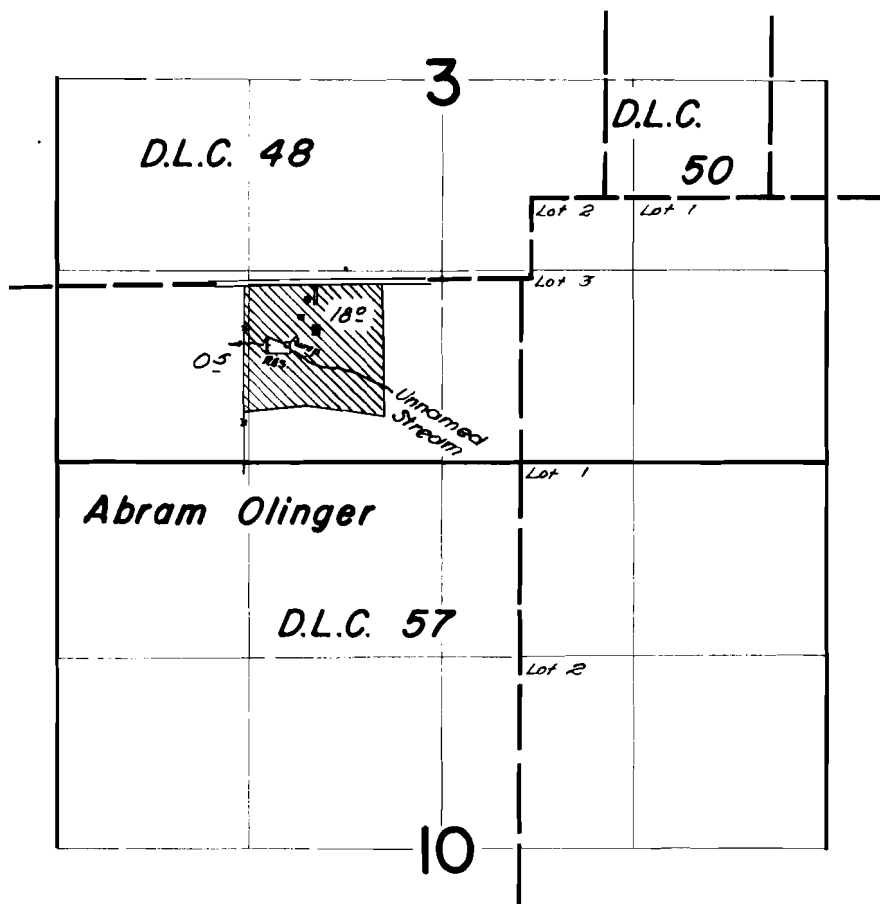

FINAL PROOF SURVEY UNDER

Application No. **R-31023** **31024** Permit No. **R-1901** **24394**
IN NAME OF

LESTER C. DAVIDSON

Surveyed *March 23 1961*, by *C. O. Bartels*.
Feb. 7 1962, by *L. Jackson*