


T.8S.R.2W.W.M.

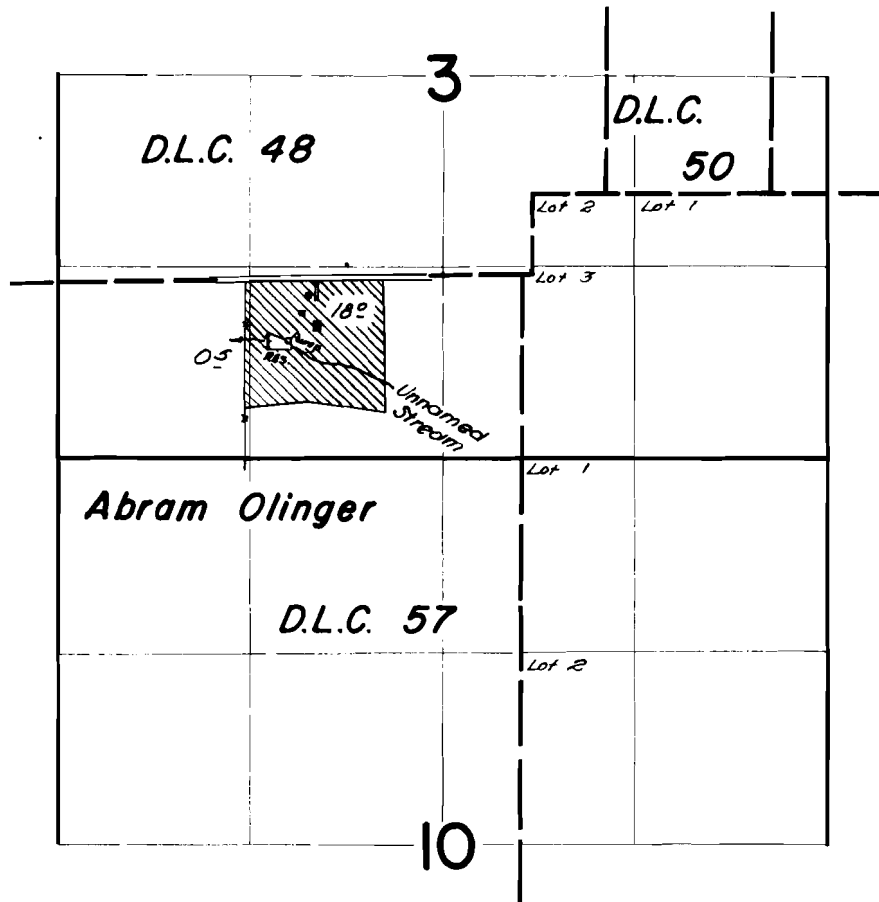

FINAL PROOF SURVEY  
UNDER

Application No. **R-31023** **31024** Permit No. **R-1901** **24394**  
IN NAME OF

**LESTER C. DAVIDSON**

Surveyed *March 23 1961*, by *C. O. Bartels*.  
*Feb. 7 1962*, by *L. C. Davidson*