


T. 9 S. R. 1 E. W. M.

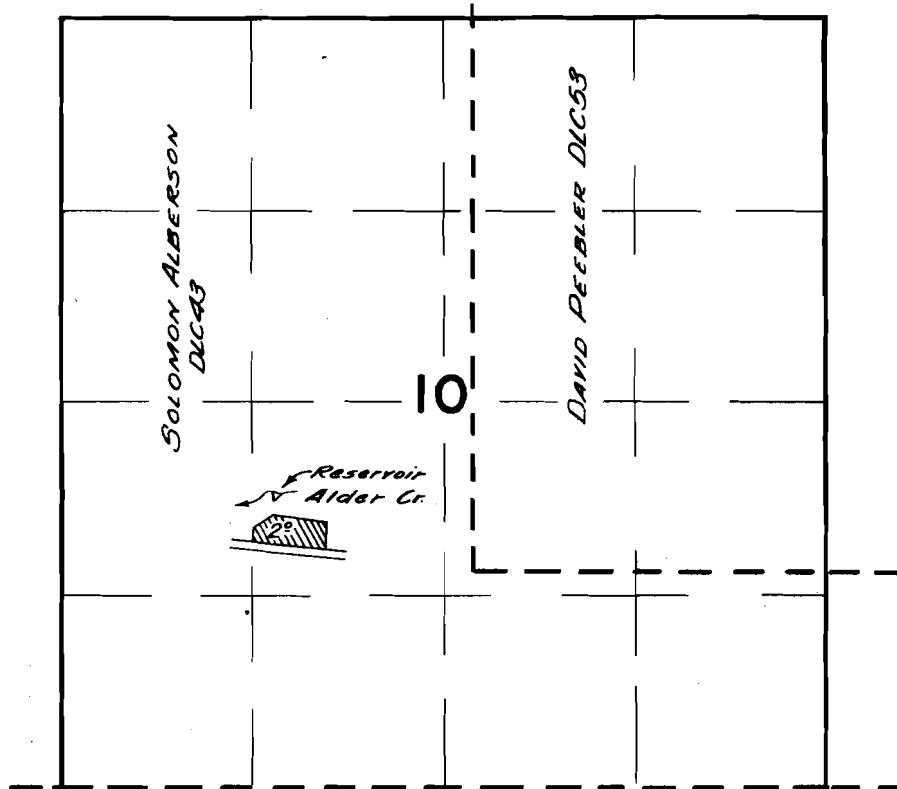

FINAL PROOF SURVEY
UNDER

Application No. ^{R-31075} 31076 Permit No. ^{R-1926} 24463
IN NAME OF

..... DOUGLAS HEATER

Surveyed April 27 1961, by *CA Bartlett*