


T. 9 S. R. 1 E. W. M.

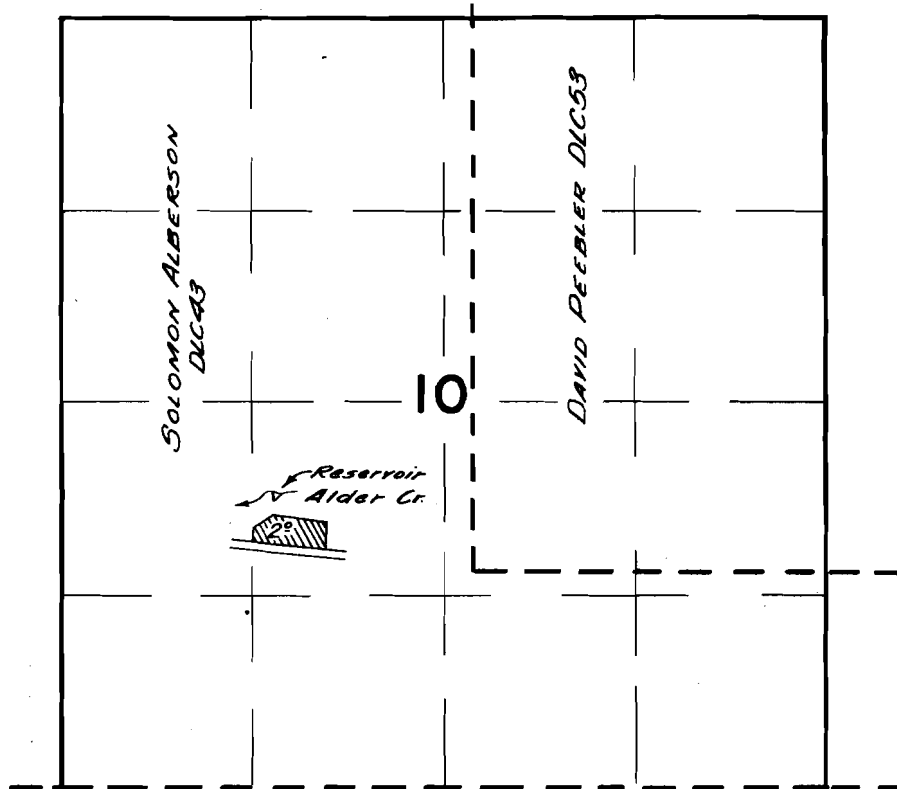

FINAL PROOF SURVEY  
UNDER

Application No. <sup>R-31075</sup> 31076 Permit No. <sup>R-1926</sup> 24463  
IN NAME OF

..... DOUGLAS HEATER .....

Surveyed April 27 1961, by *CA Bartlett*