


T.9S.R.1E.W.M.

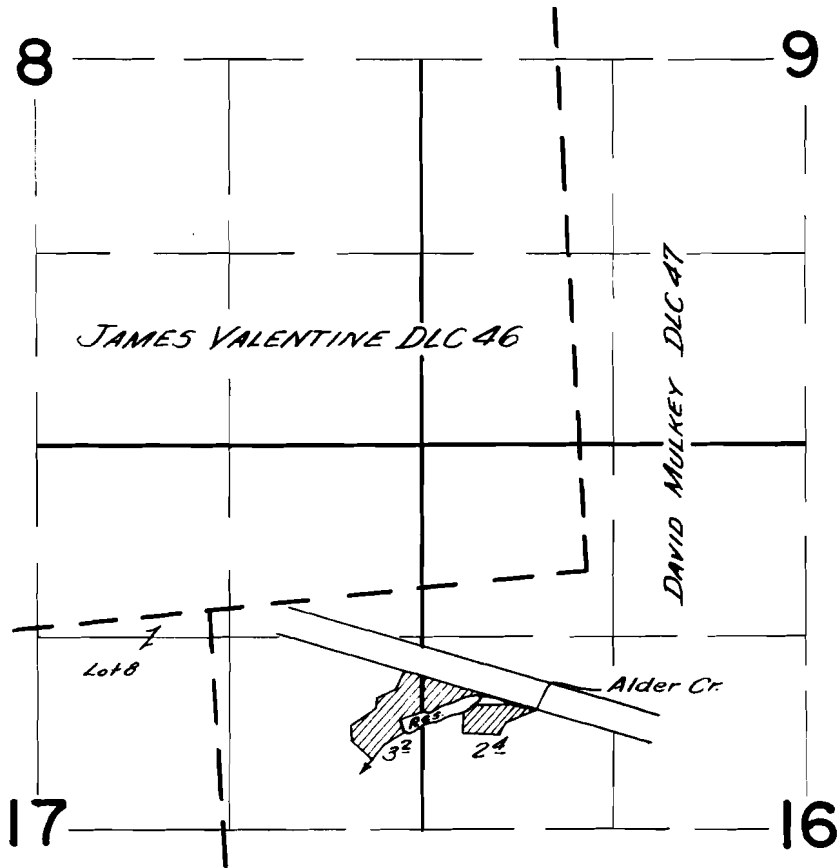

FINAL PROOF SURVEY UNDER

Application No. *R-30883* 30884 Permit No. *R-1964* 24592
IN NAME OF

ARCHIE KIMSEY

Surveyed *April 28 1961*, by *W. Bartolo*