


T.9S. R.5W.W.M.

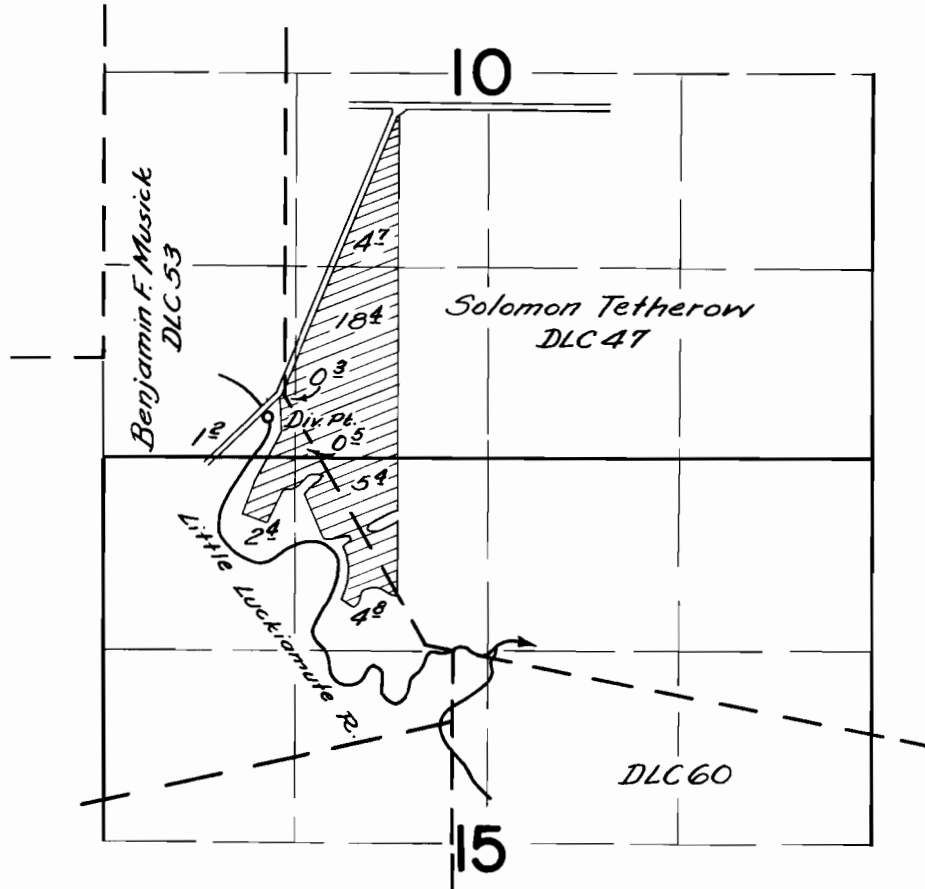

FINAL PROOF SURVEY
UNDER

Application No. 28846... Permit No. 22971...
IN NAME OF

MALCOLM H. ARMOUR

Surveyed Aug. 16 1960, by C.O. Bartels