


T.2S.R.9W.W.M.

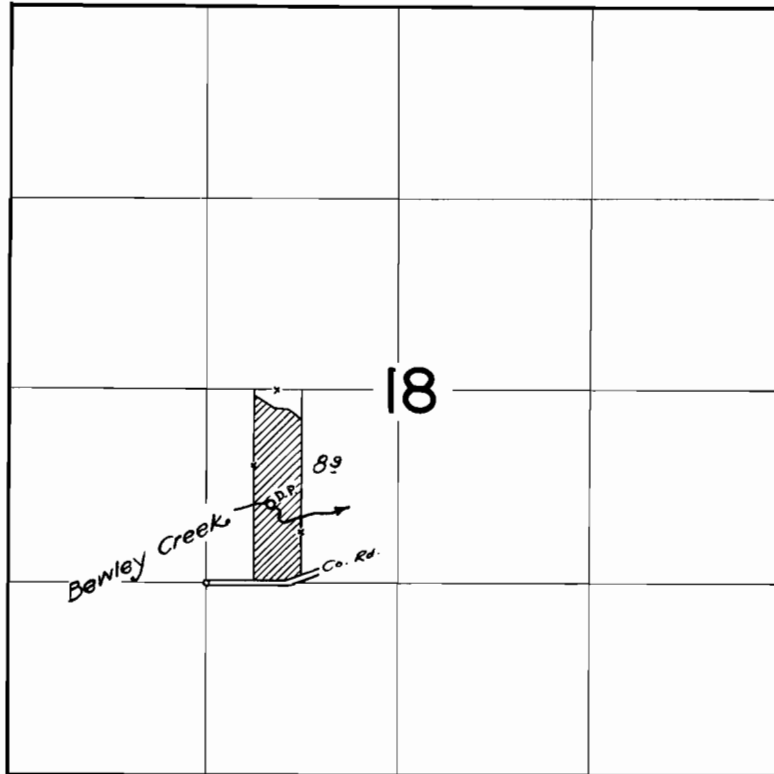

FINAL PROOF SURVEY
UNDER

Application No. 30779 Permit No. 24203
IN NAME OF

VICTOR W. SHREVE

Surveyed June 30 1961, by *L.H. Jackson*