


T.2S.R.1W.W.M.

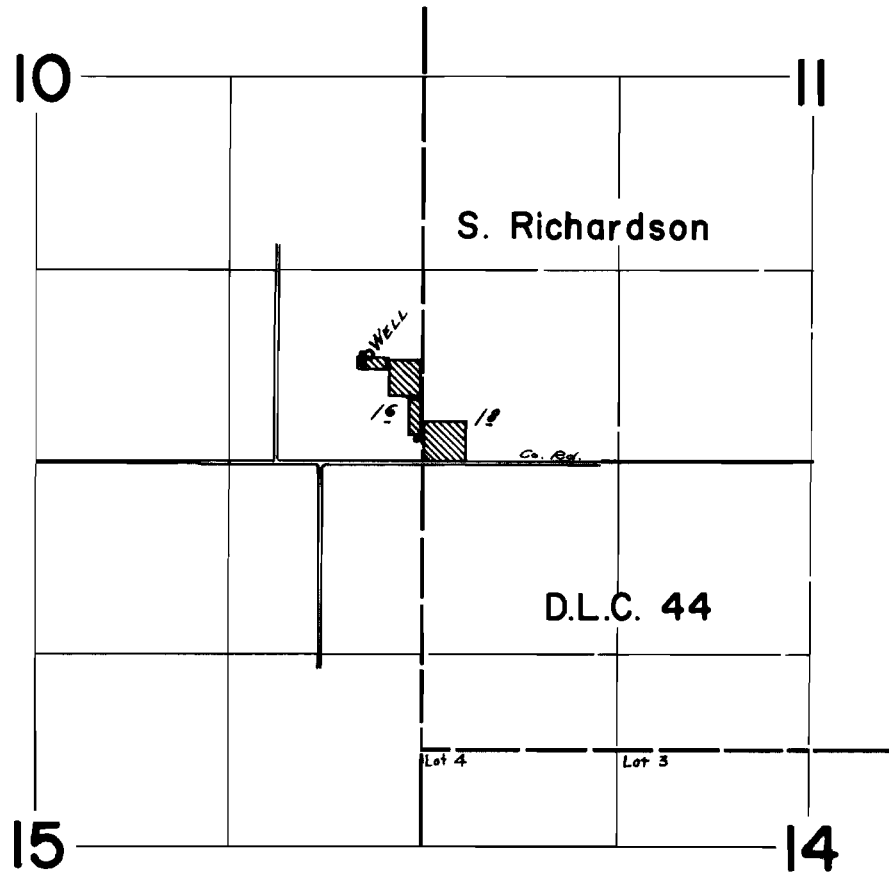

FINAL PROOF SURVEY UNDER

Application No. G-690 Permit No. G-612
IN NAME OF

J. M. HARDER

Surveyed August 17, 1961, by R. Jackson