


T.1N.R.2W.W.M.

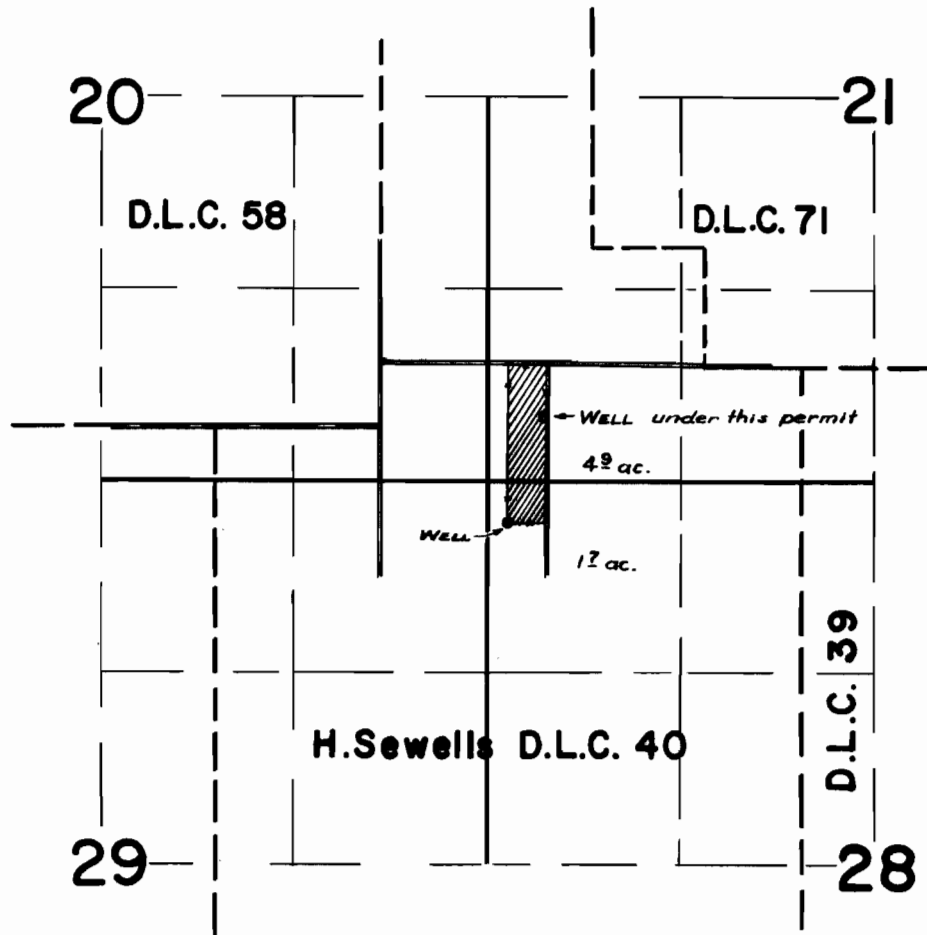

FINAL PROOF SURVEY UNDER

Application No. G-833 Permit No. G-717
IN NAME OF

L.M. WATERS

Surveyed 16 AUG. 1961, by Mr. Bish