


T.2N.R.4W.W.M.

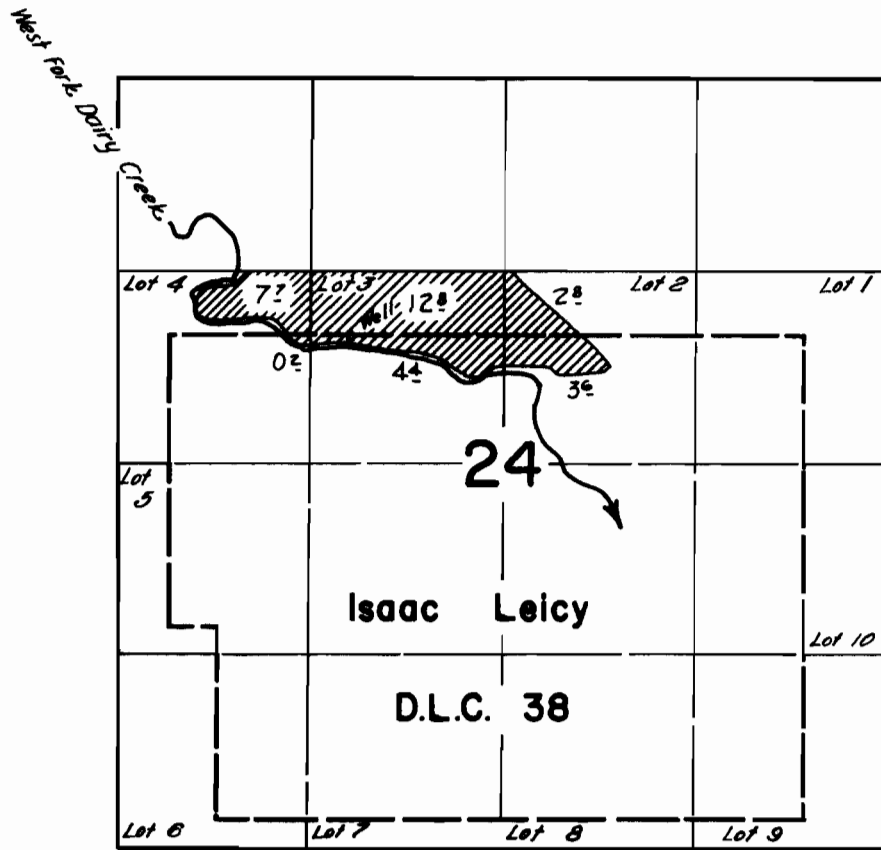

**FINAL PROOF SURVEY**  
UNDER

Application No. **G-799**..... Permit No. **G-726**.....  
IN NAME OF

**ERVIN E. MEAD**

Surveyed *July 24 1961*, by *A. Jackson*