


T.2N.R.2W.W.M.

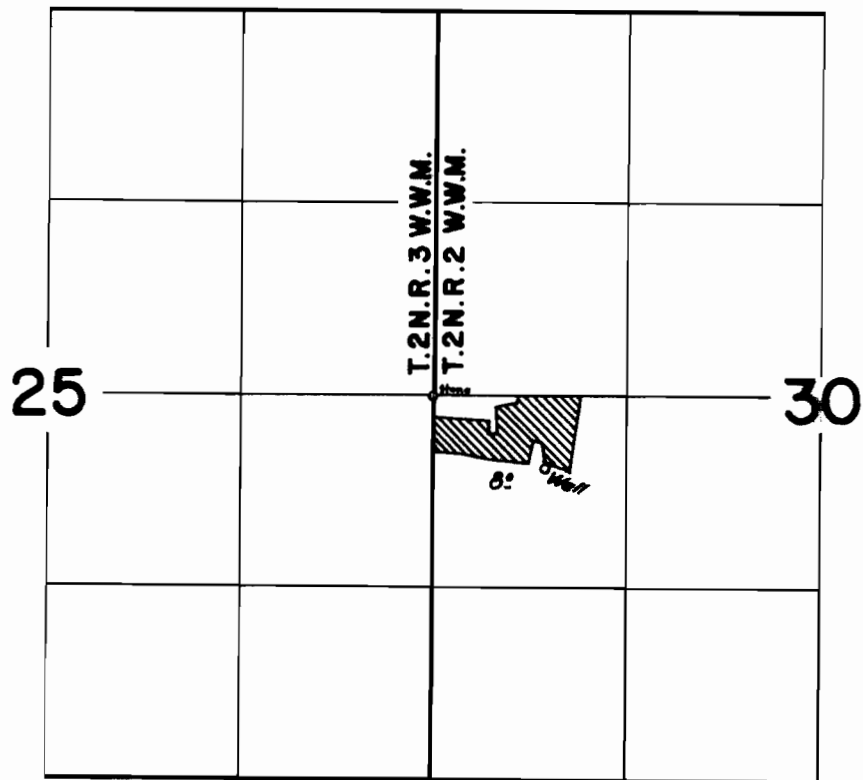

FINAL PROOF SURVEY
UNDER

Application No. G-1374 Permit No. G-1247
IN NAME OF

FELIX DEVLAE MINCK

Surveyed August 14 1961, by *R. Jackson*