


T.2S.R.2W.W.M.

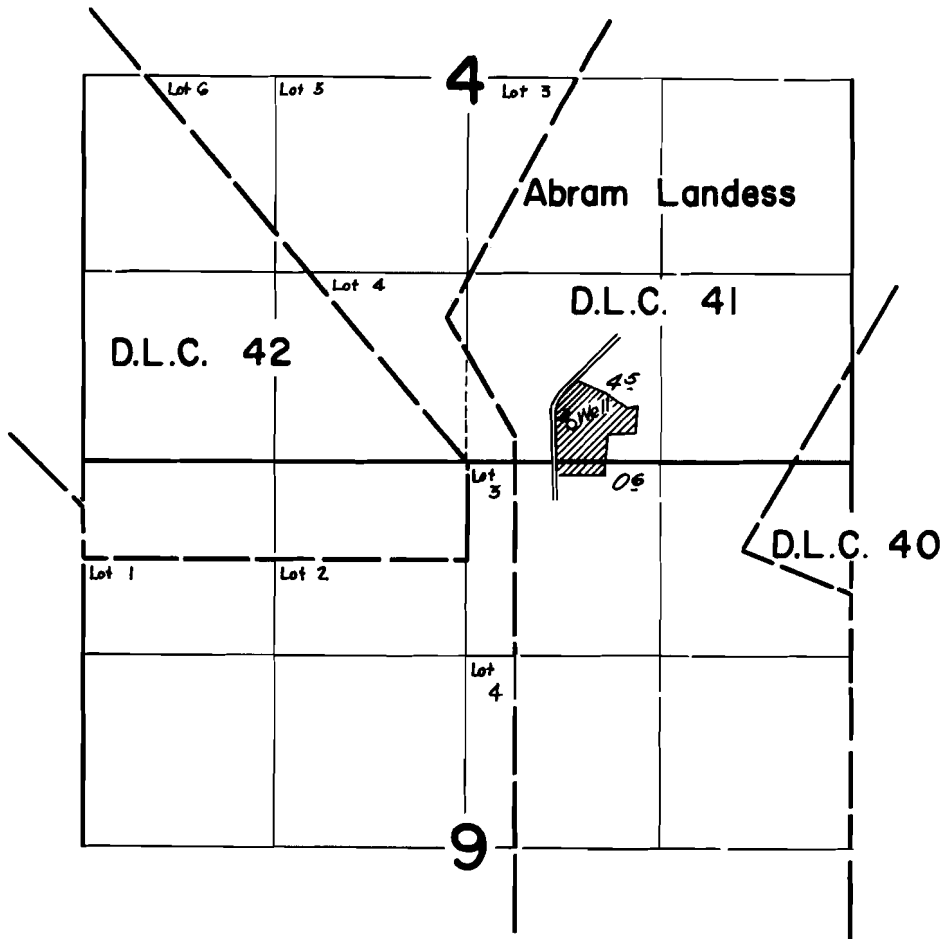

FINAL PROOF SURVEY UNDER

Application No. G-1617 Permit No. G-1529
IN NAME OF

FRANK BROOKS

Surveyed June 21, 1961, by R. Jackson