


# T. I. S. R. I. W. W. M.

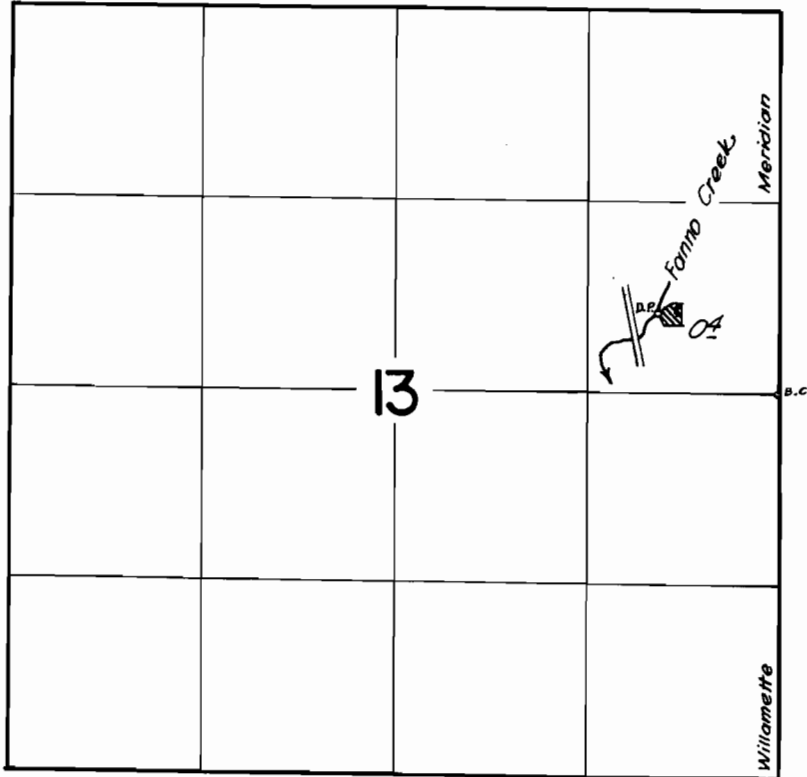

## FINAL PROOF SURVEY UNDER

Application No. **30619** Permit No. **24123**  
IN NAME OF

**MRS. JOHN P. FEUERSTEIN**

Surveyed *June 20* 1960, by *R. A. Jackson*